WAR DEPARTMENT

CORPS OF ENGINEERS, U. S. ARMY

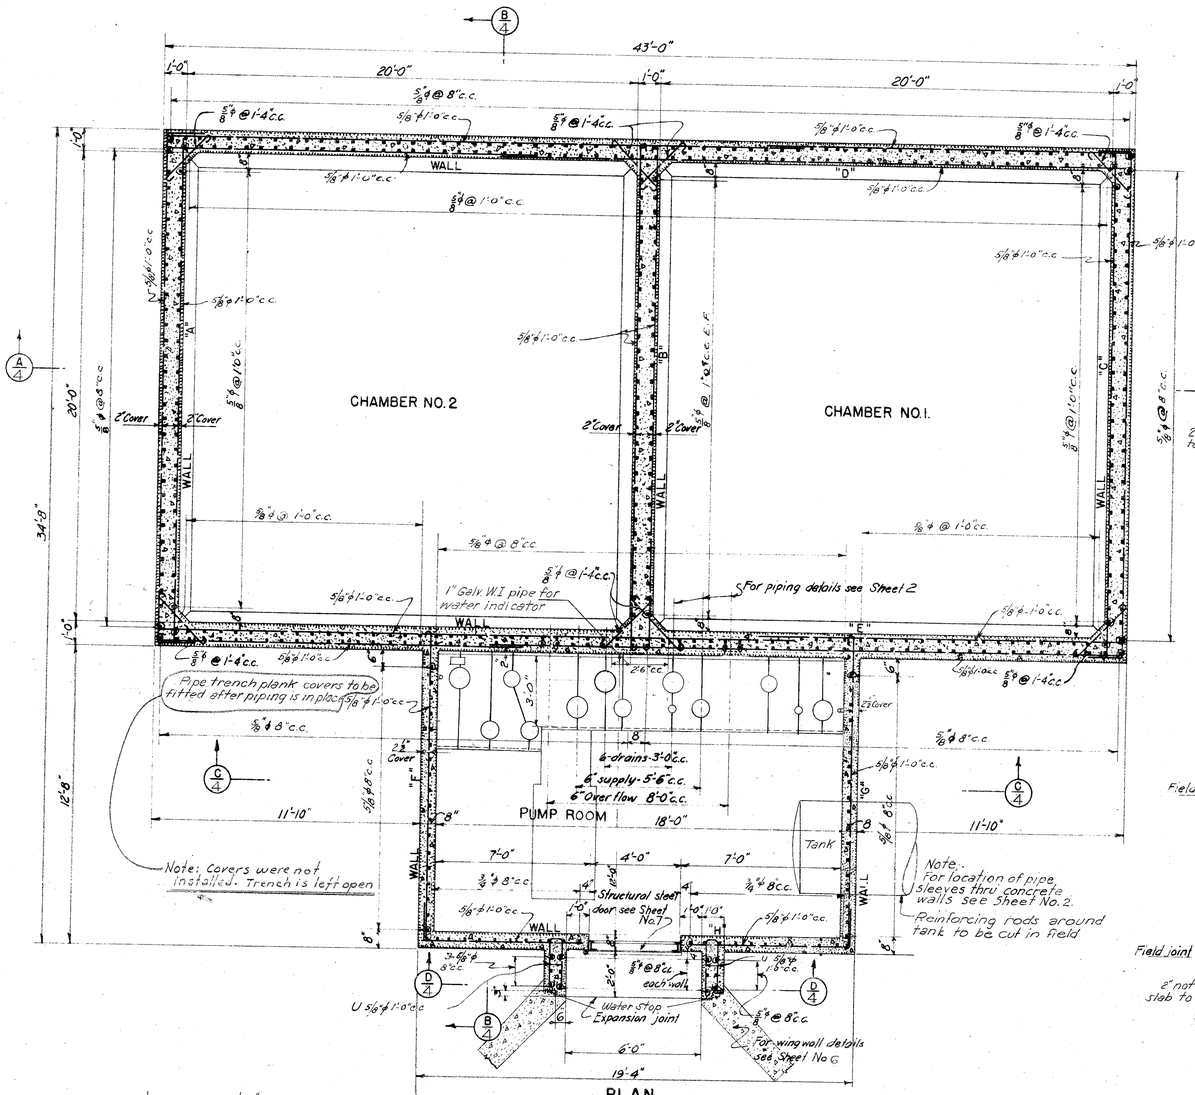

PLAN
SCALE: 3/8" = 1'-0"

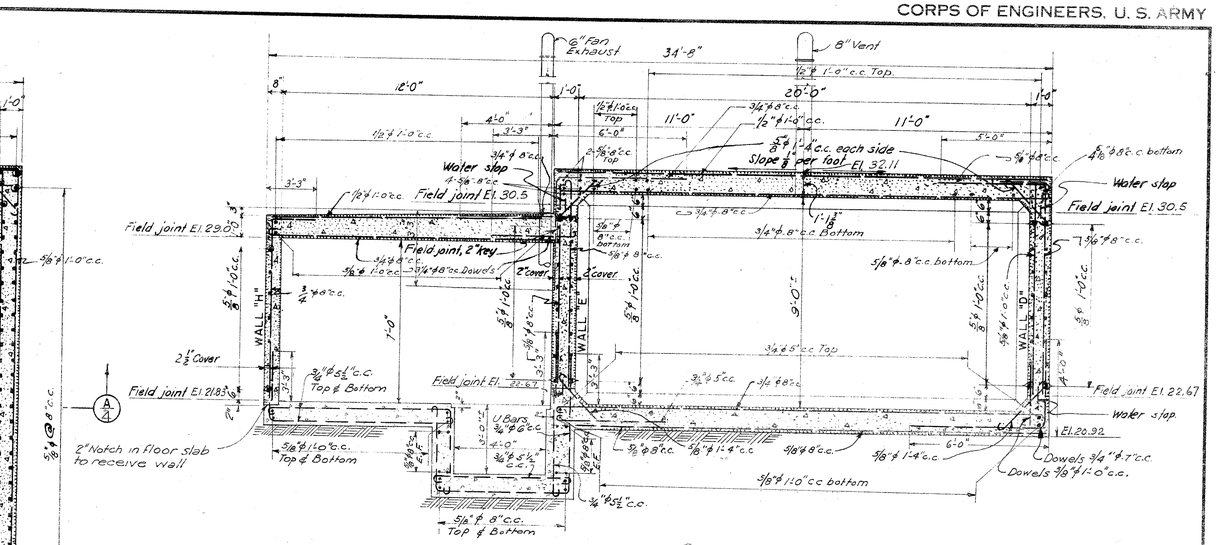

SECTION B/4
SCALE: 3/8" = 1'-0"

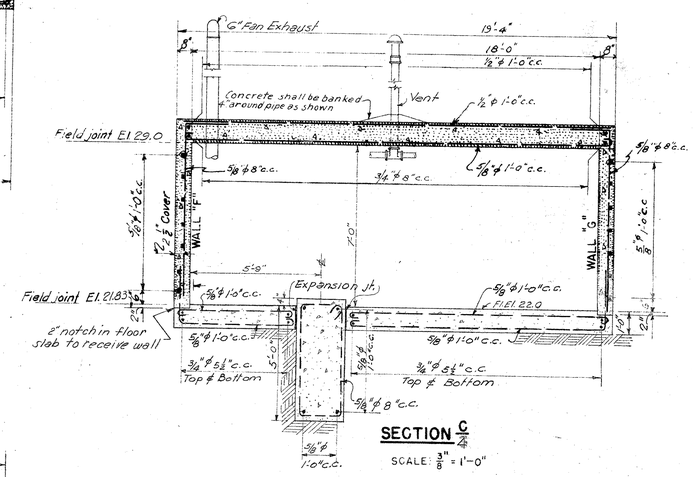

SECTION C/4
SCALE: 3/8" = 1'-0"

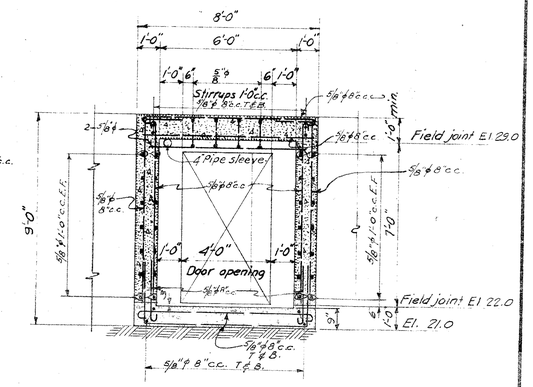

SECTION D/4
SCALE 3/8" = 1'-0"

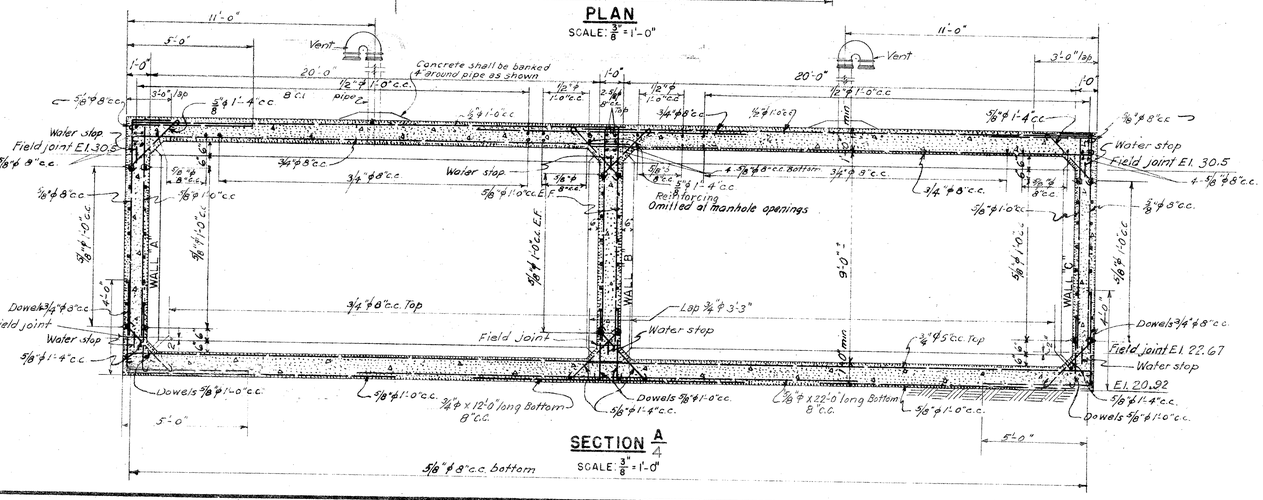

SECTION A/4
SCALE: 3/8" = 1'-0"

NOTES

For general notes see Sheet No. 3

DATE	REV. NO.	REVISION	REV. BY	AP. BY	DOC. NO.
7-21-44		Final Field changes made for RECORD DRAWING			

RECORD DRAWING

HARBOR DEFENSES

BATTERY 104

RESERVOIR WATER SUPPLY SYSTEM

RESERVOIR WALL DETAILS

IN 9 SHEETS SHEET NO. 4 SCALE AS SHOWN

U.S. ENGINEER OFFICE BOSTON, MASS. NOV. 1942

APPROVAL RECOMMENDED: John E. Allen — CHIEF, W.A.R. AND FLOOD CONTROL SUBDIVISION

APPROVED: G. W. Lincoln — COLONEL, CORPS OF ENGINEERS, DISTRICT ENGINEER

SUBMITTED: — CHIEF, DESIGN SECTION, SR. ENGINEER

ASSOCIATE ENGINEER

DES. BY. DR. BY. L.H.M. TR. BY. CH. BY. E.P.R.

FILE NO. 4-8-3-10/4