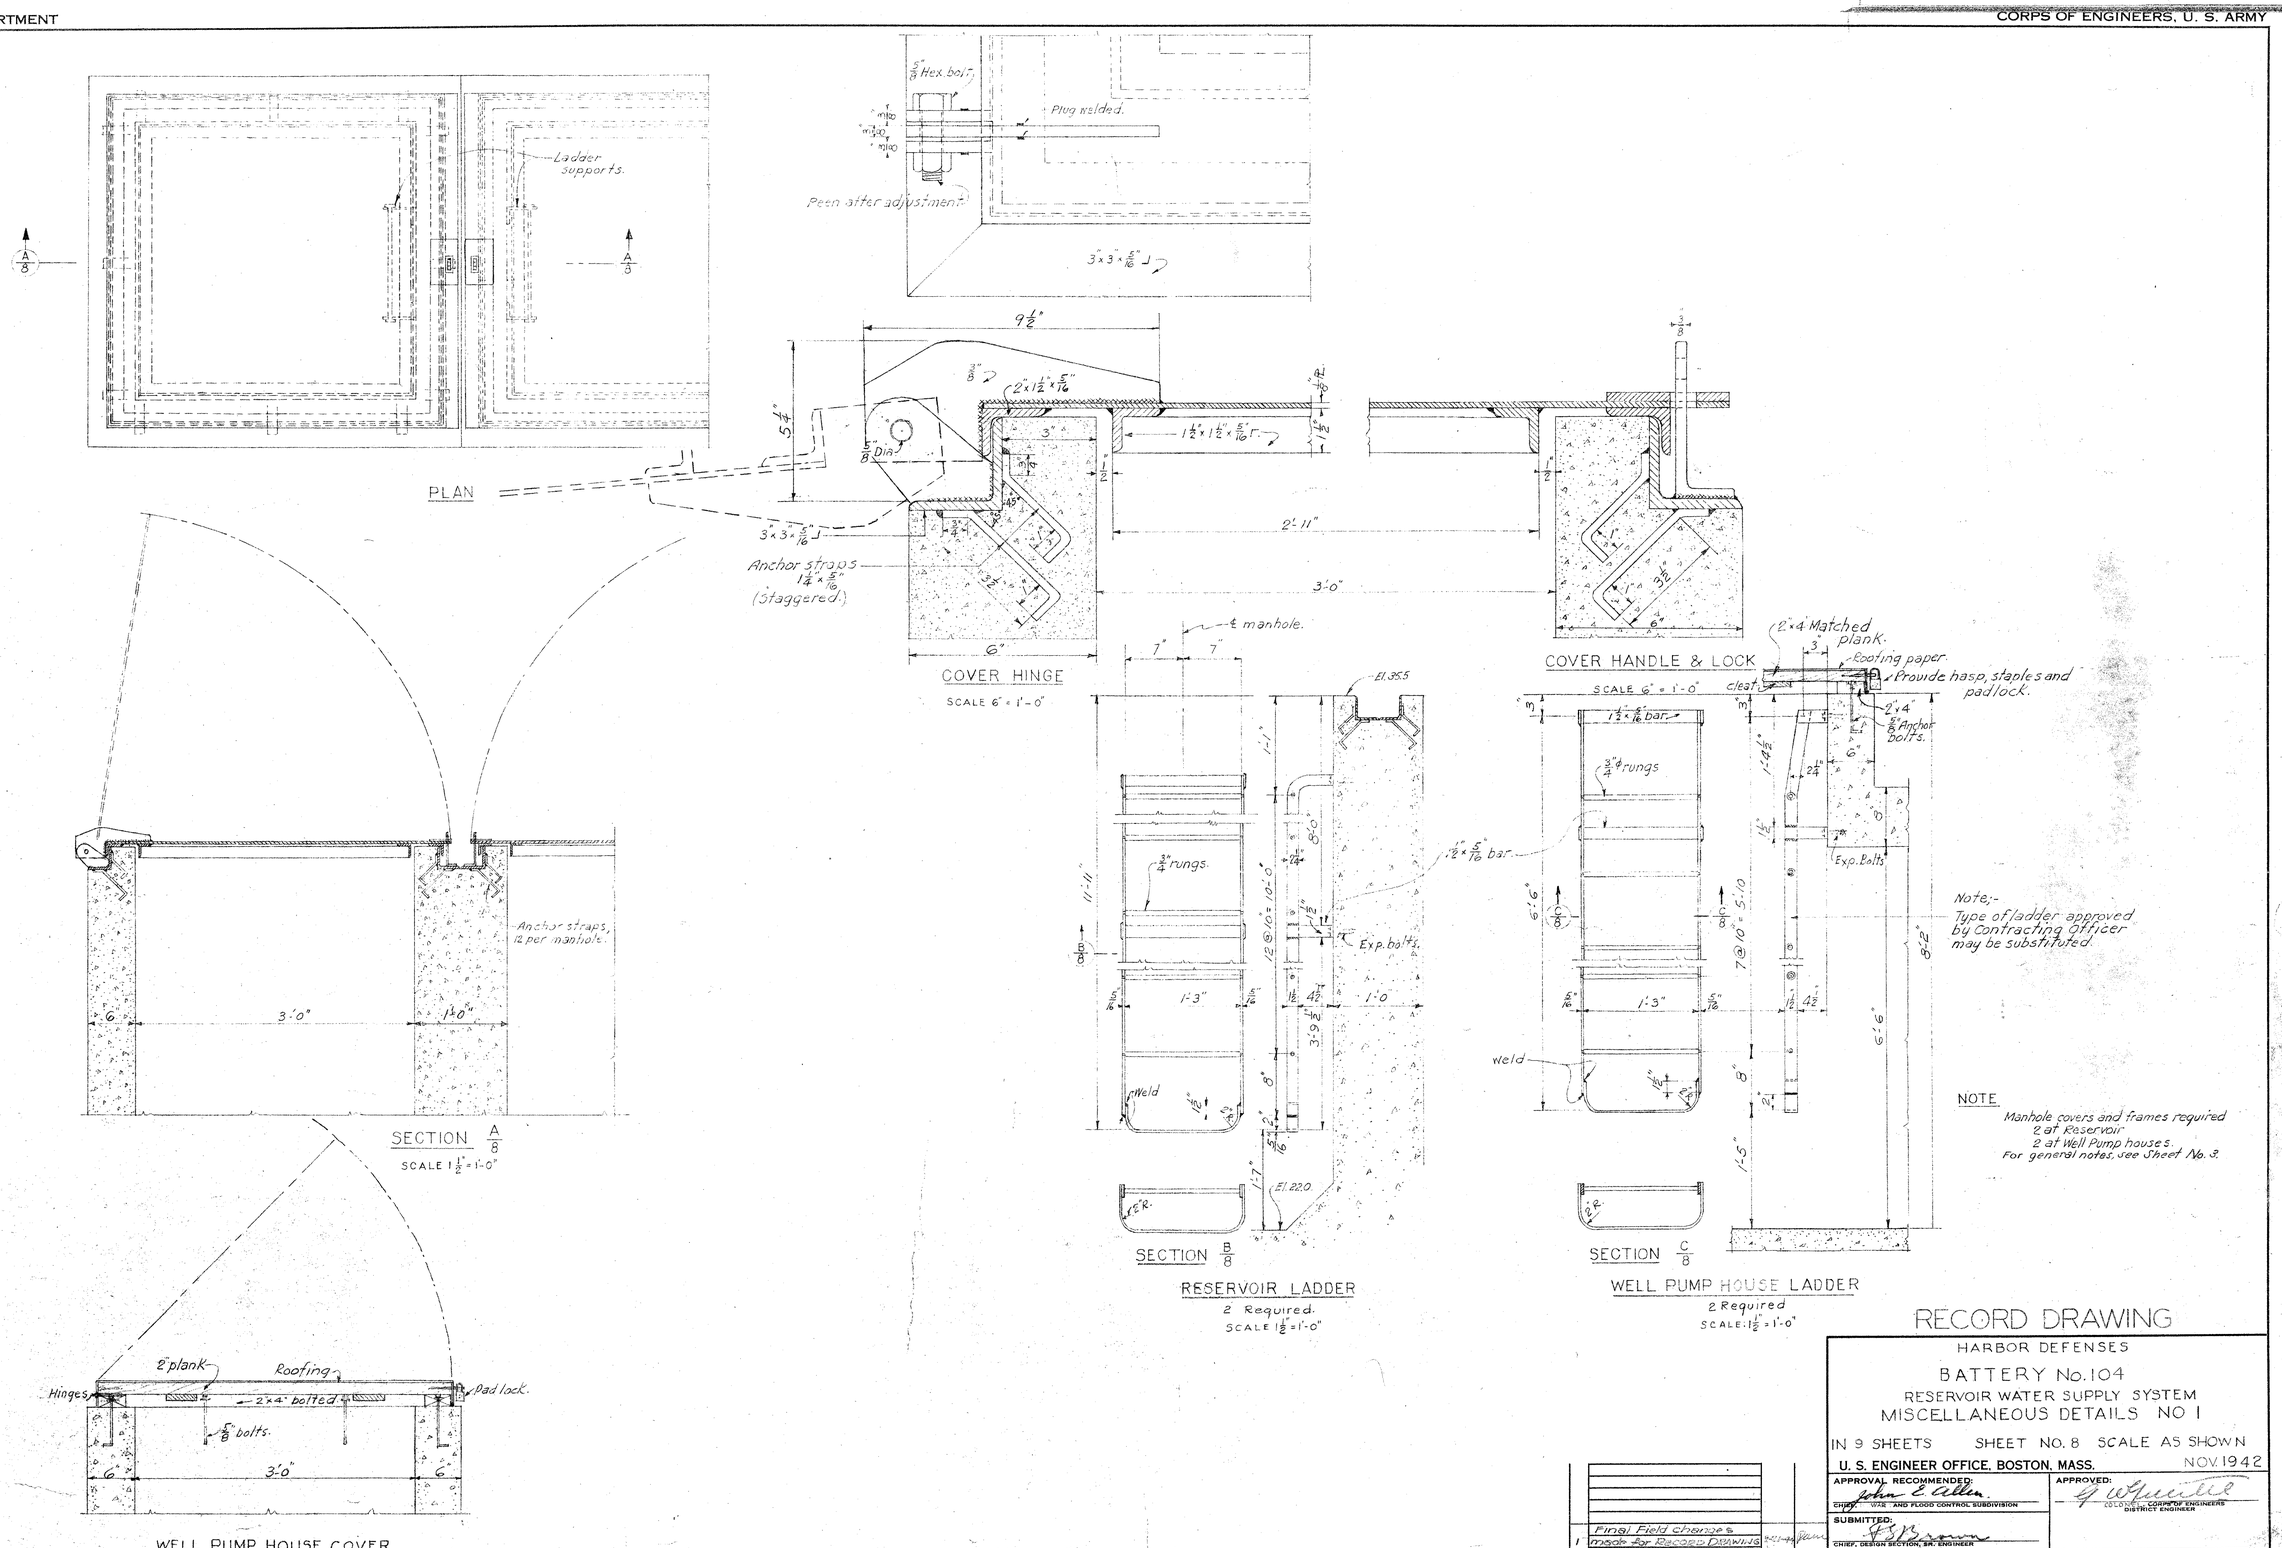

RECORD DRAWING

HARBOR DEFENSES

BATTERY No. 104

RESERVOIR WATER SUPPLY SYSTEM

MISCELLANEOUS DETAILS NO I

IN 9 SHEETS SHEET NO. 8 SCALE AS SHOWN

U. S. ENGINEER OFFICE, BOSTON, MASS. NOV. 1942

NO.	CHARACTER	DATE	BY
1	Final Field changes made for Record Drawing		

REVISIONS

APPROVAL RECOMMENDED: John E. Allen
CHIEF, WAR AND FLOOD CONTROL SUBDIVISION

APPROVED: G. W. Lincoln
COLONEL, CORPS OF ENGINEERS
DISTRICT ENGINEER

SUBMITTED: F. S. Brown
CHIEF, DESIGN SECTION, BR. ENGINEER

Elliot F. Chase
ASSOC. ENGINEER

DES. BY
DR. BY
TR. BY
CH. BY

FILE NO. 4-8-3-10/8