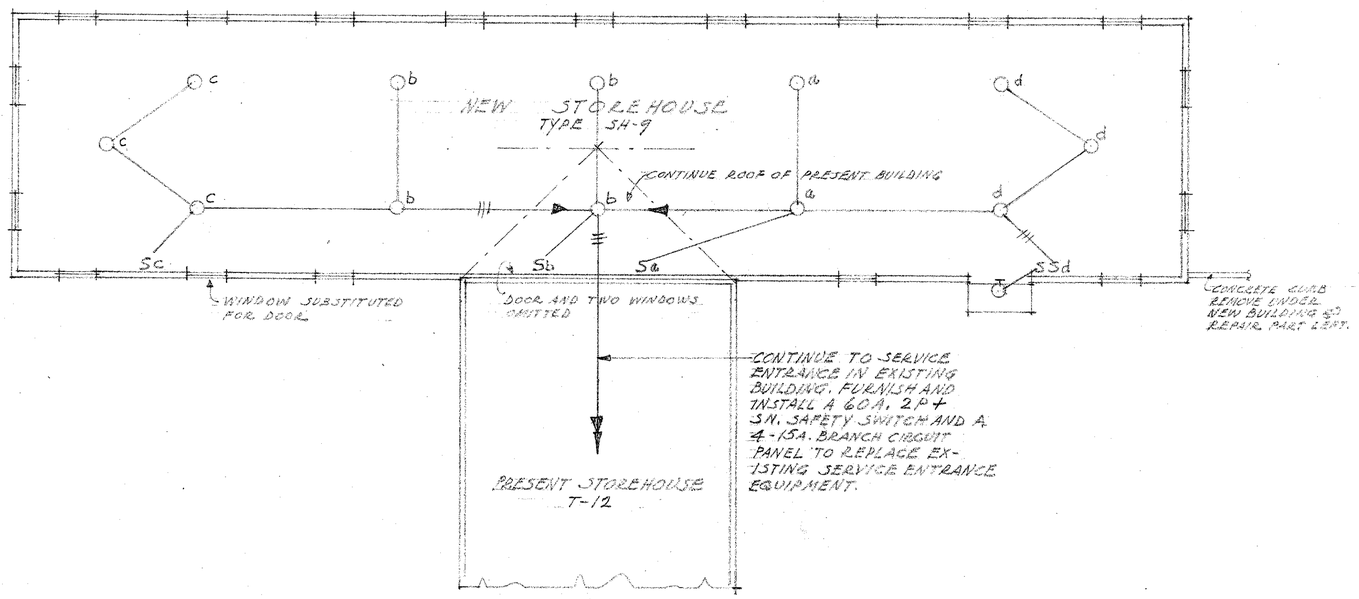

MODIFIED FLOOR PLAN
SCALE 1/8" = 1'-0"

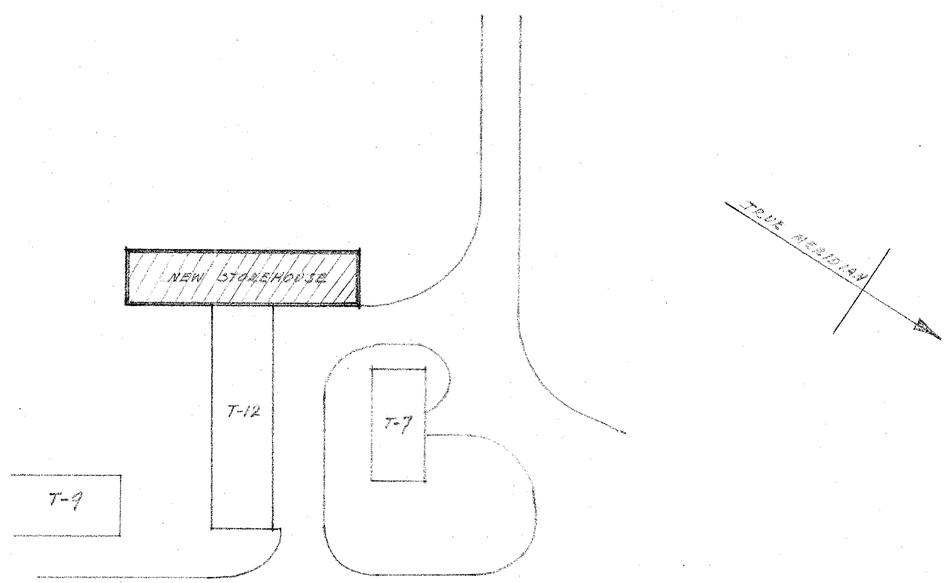

PLOT PLAN
SCALE 1" = 40'-0"

RECORD DRAWINGS

HARBOR DEFENSES OF BOSTON
FORT DAWES DEER ISLAND MASS.
STOREHOUSE TYPE SH-9
PLOT PLAN AND MODIFIED FLOOR PLAN
SCALE AS SHOWN.

U. S. ENGINEER OFFICE, BOSTON, MASS. MARCH 12, 1942.

APPROVAL RECOMMENDED: CHIEF, DEFENSE AND FLOOD CONTROL SUBDIVISION		APPROVED: COLONEL, CORPS OF ENGINEERS DISTRICT ENGINEER.	
SUBMITTED: CHIEF, DESIGN SECTION, SR. ENGINEER.		APPROVAL RECOMMENDED: MAJOR, SEA COAST DEFENSE SECTION	
ASSOCIATE ENGINEER.	DES. BY DR. BY TR. BY CH. BY	FILE NO. 4-7-4-7	

NO	CHARACTER	DATE	BY
1	Record dwg. no changes	5/17/44	P.C.

REVISIONS