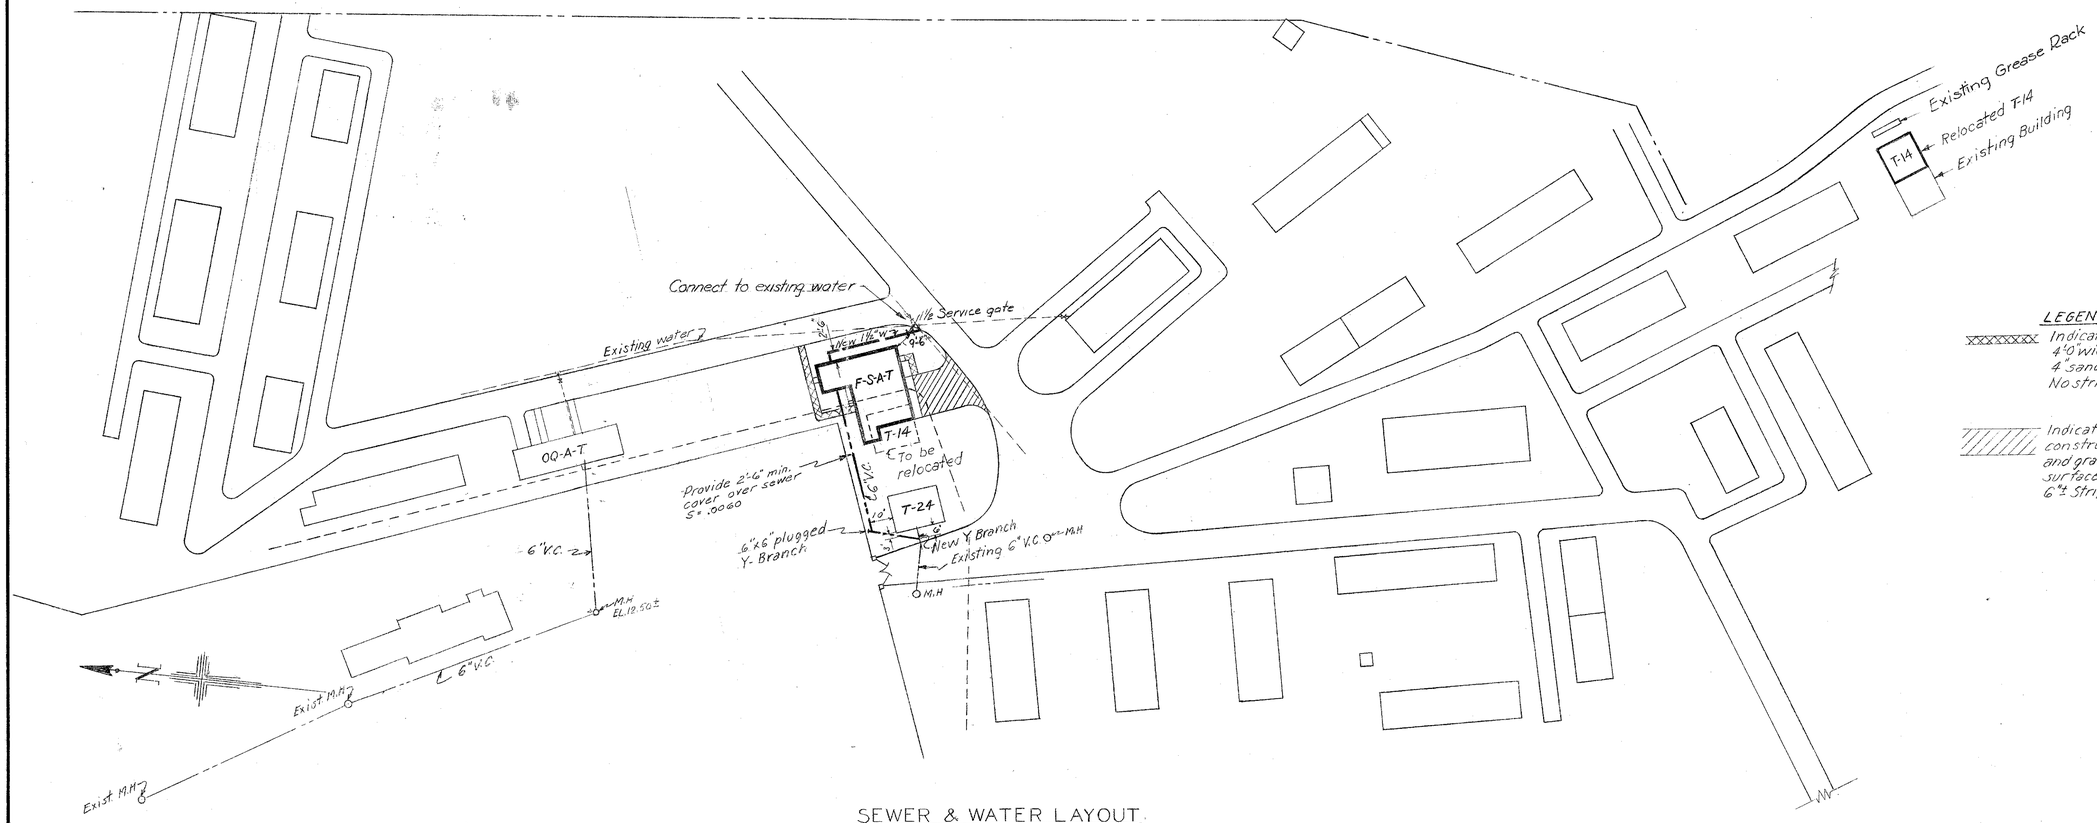

SEWER & WATER LAYOUT

LEGEND

Indicates sidewalk 4'-0" wide constructed of 4" sand and gravel. No stripping required.

Indicates driveway constructed of 8" sand and gravel, bituminous surface treatment 6" ± Stripping.

Note:
For sewer and water details, see Dwg. No. X100-1/1 attached to specifications.

RECORD DRAWINGS

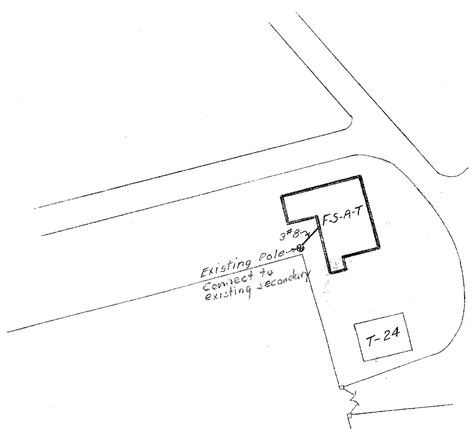

ELECTRICAL LAYOUT

Note:
All existing underground cables in the building area shall be carefully protected against damage; creosoted wooden troughs shall be constructed around these cables to provide raceways before proceeding with the construction of the Fire Station

NO.	CHARACTER	DATE	BY
3	Final field changes	2-11-44	J.E.L.
2	T-14 Relocated	12-7-43	
1	T-14 added	12-3-43	J.E.L.

REVISIONS

HARBOR DEFENSES OF BOSTON

FORT DAWES

FIRE STATION, TYPE F-S-A-T, MODIFIED

LOCATION AND UTILITIES PLAN

SCALE: 1" = 50'

U. S. ENGINEER OFFICE, BOSTON, MASS. ~~30 Nov. 1943~~

APPROVAL RECOMMENDED: John E. Allen
CHIEF ENGINEERING DIVISION

APPROVED: [signature]
LT. COLONEL, CORPS OF ENGINEERS
DISTRICT ENGINEER

SUBMITTED: [signature]
CHIEF, DESIGN SECTION, SR. ENGINEER

[signature]
ENGINEER

DES. BY
DR. BY B.T.N.
TR. BY
CH. BY

FILE NO. 4-7-4-26/1