ROOF FRAMING PLAN
SCALE: 1"=10'

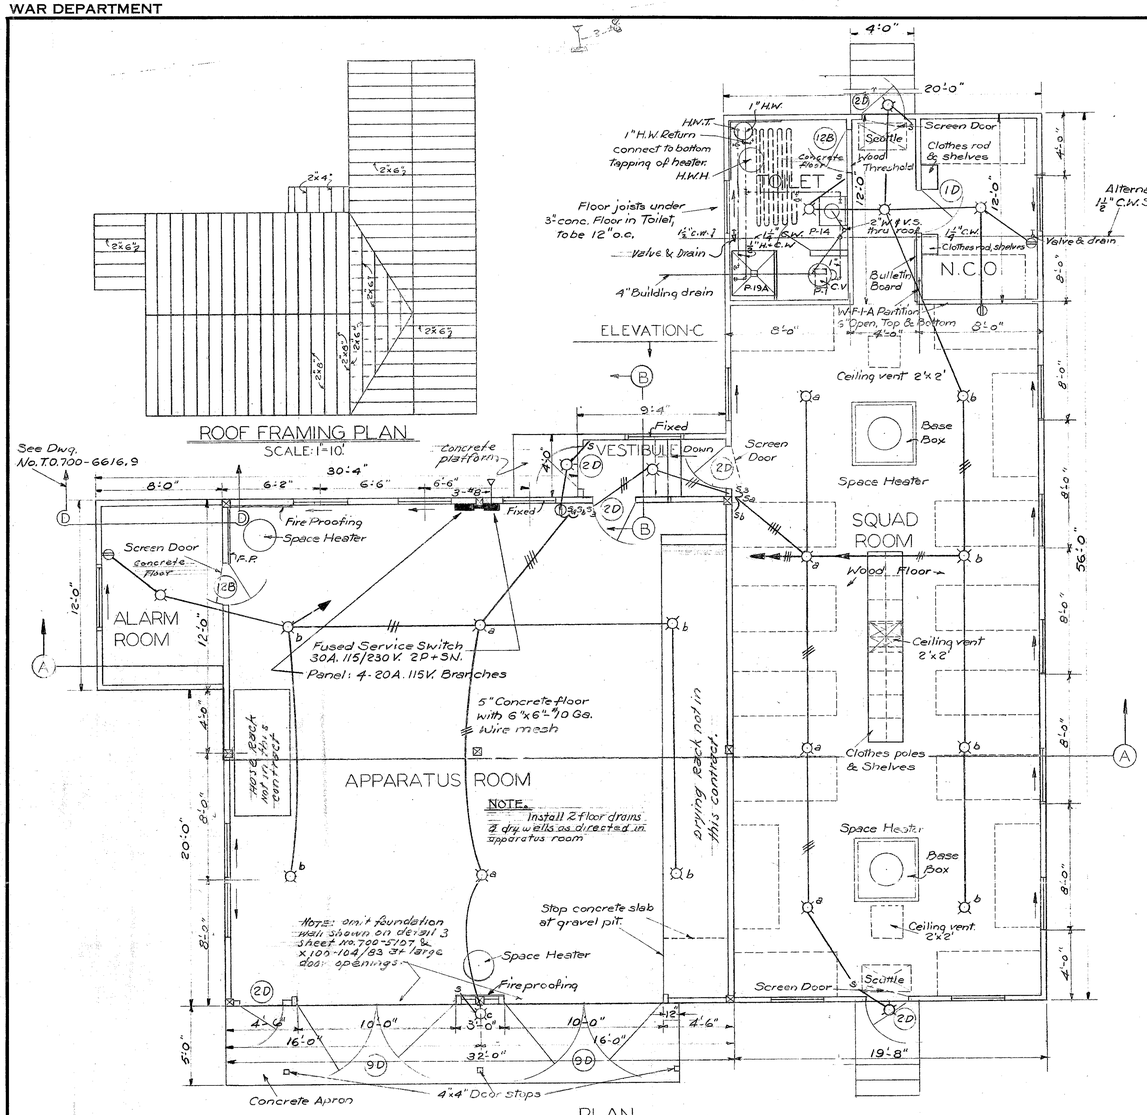

ELEVATION-C

PLAN
SCALE 1/4"=1'-0"

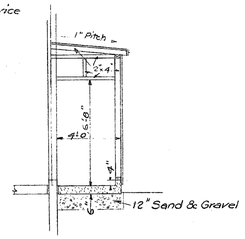

SECTION-BB
SCALE 1/4"=1'-0"

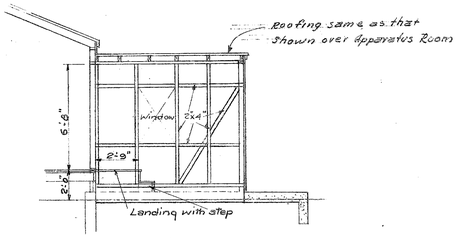

ELEVATION-C SCALE 1/4"=1'-0"

OUTSIDE FINISH REMOVED, SHOWING STUD FRAMING FOR VESTIBULE.

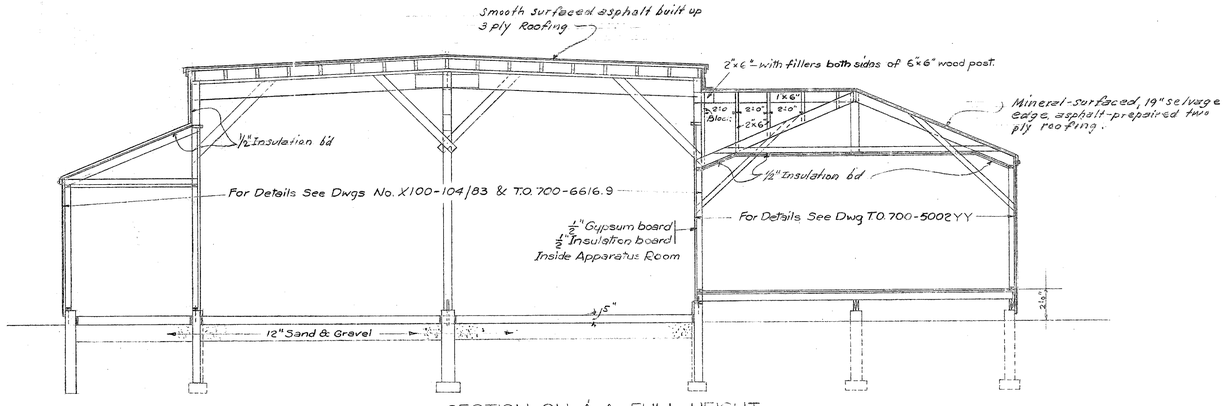

SECTION ON A-A, FULL HEIGHT
SCALE 1/4"=1'-0"

DRAWING NUMBERS APPLYING TO THIS BUILDING

DRAWING NO.	TITLE	DETAILS	LATEST REV. DATE
A-7-4-26/1	LOCATION & UTILITES.		
A-7-4-26/2	MODIFIED PLAN		
T.O.700-6616.9	PLANS, ELEVATION, SECTION & DETAILS		10/4/43
T.O.700-5002YY	FOUNDATION & MISCELLANEOUS DETAILS	AS REQUIRED	10/18/43
X100-104/83	STANDARD FRAMING DETAILS (32'-6 WIDE BLDG.)	EXCEPT MONITOR	
T.O.700-3100	" WINDOW "	1-2-5-7	4/26/43
T.O.700-5106	" DOOR "	1-3-4-7-14	3/20/43
T.O.700-5151X	" MISCELLANEOUS DETAILS	1-4-5-7-8-9	9/28/43
T.O.700-5153	" " "	1-6-10	1/20/43
T.O.700-5158	" " "	2 MOD. 7-5-12-21	2/17/43
700-3149	" ELECTRICAL (IN SPECS)		
T.O.700-5155	" MISCELLANEOUS DETAILS	3-4	11/18/43
T.O.700-5503			2/8/43
800-194 X	" PLUMBING DETAILS	AS REQUIRED	4/30/43
T.O.700-5107	" DOOR DETAILS	3	5/15/43

- GENERAL NOTES -

1. For general notes & drawing numbers that apply to this building see Drwg No. 700-6616.9
2. NOTE: Gable end louvers to be used instead of ridge ventilators as shown on Dwg 700-6616.9.

RECORD DRAWINGS

NO.	CHARACTER	DATE	BY
1	Record Drawing - No changes	2-11-46	J.E.L.

REVISIONS

HARBOR DEFENSES OF BOSTON

FORT DAWES

FIRE STATION

TYPE F-S-A-T MODIFIED

SCALE AS SHOWN

U. S. ENGINEER OFFICE, BOSTON, MASS. OCTOBER 1943

APPROVAL RECOMMENDED: John E. Allen — CHIEF ENGINEERING DIVISION

APPROVED: — LT. COLONEL, CORPS OF ENGINEERS, DISTRICT ENGINEER

SUBMITTED: — CHIEF, DESIGN SECTION/SR. ENGINEER

ENGINEER — DES. BY, DR. BY, TR. BY, CH. BY

FILE NO. 4-7-4-26/2