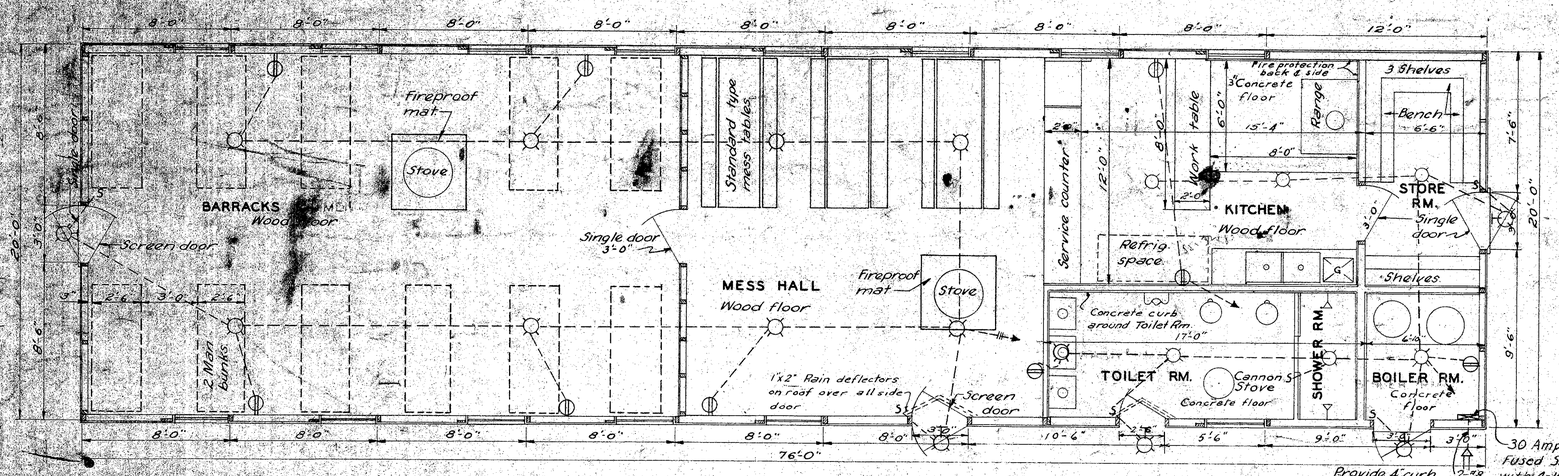

TYPE "D" BUILDING

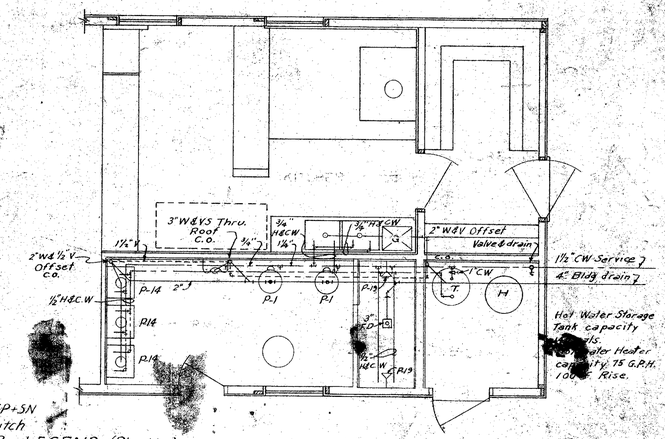

PLUMBING LAYOUT

LEGEND - (Plumbing)

- Cold water
- Hot water
- Drain
- Vent
- C.O. Cleanout

FIXTURE SCHEDULE		
ROOM DESIGNATION	TYPE	WATT
Barracks	CPS	100
Mess Hall	CPS	100
Kitchen	CPS	100
Wash Room ceiling	CPS	100
" " bracket	COS	40
Shower Room	J.S	40
Boiler Room	CS	60
Store Room	CPS	60
Entrance Lights	F	50

NOTE: DRAWING NOS.

T.O. 700-5150	Misc. details
5100	Std. window details
5151X	Std. misc. details
5002YY	Framing & misc. details
5153	Misc. details
5199	Electrical
5106	Std. door details
5154	Mess furniture details
5156	Mess Hall ventilating
800-194X	Plumbing details
2333A	Ventilator details

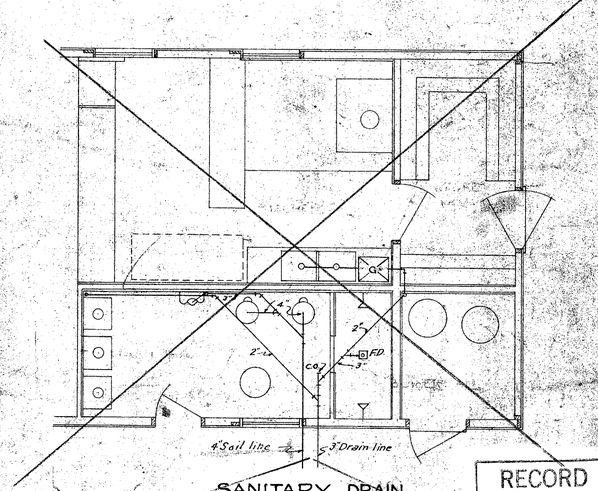

SANITARY DRAIN
(When Septic Tank is used)
NOT USED

RECORD DRAWINGS

STANDARD PLANS.
USED WITHOUT CHANGE:

PLAN NO.	TITLE.	LATEST REVISIONS.

LEGEND.

No	CHARACTER OF REVISIONS.	Date	By
1	Record Dwg. No Changes.	7/14/5	ARP

THEATER OF OPERATIONS
FORT DAWES, BOSTON HARBOR, MASS.
TYPE "D" BUILDING
BARRACKS, MESS HALL, & KITCHEN.
SCALE 1/4"-1'-0"

U.S. ENGINEER OFFICE, BOSTON, MASS.

APPROVAL RECOMMENDED: John E. Allen
CHIEF, WAR AND FLOOD CONTROL DIVISION

APPROVED: [illegible]
COLONEL, CORPS OF ENGINEERS
DISTRICT ENGINEER

SUBMITTED: [illegible]
CHIEF, DESIGN SECTION - SR. ENGINEER

ASSOC. ENGINEER
DES. BY
DR. BY
TR. BY J.E.P.
CH. BY

FILE NO. X100-103/3.1