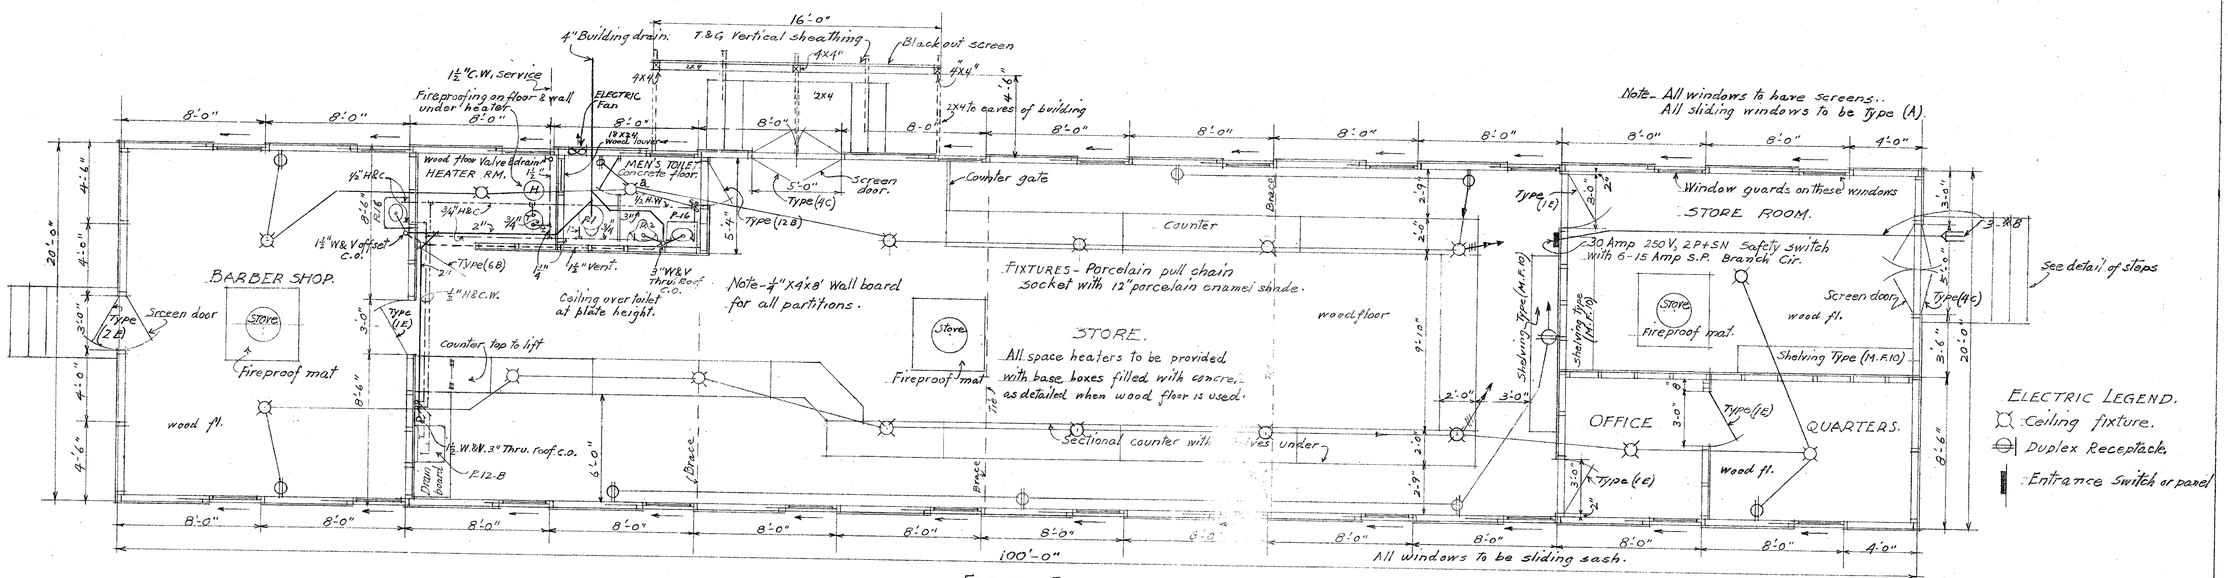

FLOOR PLAN.
Scale 1/4"=1'-0"

ELECTRIC LEGEND.
- Ceiling fixture.
- Duplex Receptacle.
- Entrance Switch or panel

FIXTURE SCHEDULE.		
ROOM DESIGNATION	TYPE	WATTS
BARBER SHOP	APS	150
STORE	APS	100
HEATER ROOM	APS	40
MENS TOILET	AS	60
STORE ROOM	APS	100
OFFICE	APS	100
QUARTERS	APS	100.

NOTE: ALL WIRING TO BE TYPE CNX OR PAPER INSULATED.
FOR DETAILS OF ELECTRICAL FIXTURES REFER TO DRWG No 700-3149.

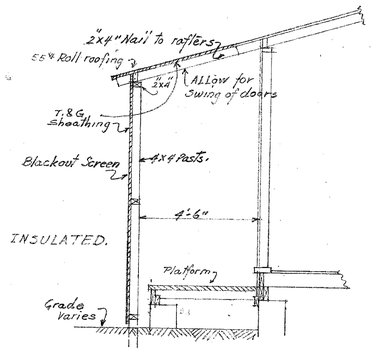

DETAIL OF BLACKOUT SCREEN.
Scale 3/8"=1'-0"

PLUMBING LEGEND
- Soil & Drain
- Vent — V
- Cold water — C.W.
- Hot water — H.W.
- Value
- Clean out — C.O.
- Notes — Hot water storage tank capacity 30 gals. Hot water heater capacity 15 g.p.h.-100°F rise.

DRAWING NUMBERS APPLYING TO THIS BUILDING.

800-2333 A	Ridge ventilators
700-3135.	Metal smoke jack & pipe (Detail #1)
TO-700-5002Y.	Typical details
800-194X.	Plumbing details.
700-3149	Electrical details
700-5153	Platform & step details (Detail #1)
700-5100	Window details (#1-2-5)
700-5106	Door details.
700-5151	Detail (#1-3-4)
700-5154	Detail (#1-12)

Note - Provide (3) wood ventilators to be located by contracting officer.

RECORD DRAWINGS

No	CHARACTER	DATE	BY.
2.	Record Dwg: No Chg's.	7/4/45	AWD.
1.	File No. changed from 103/21.1 to 103/21.3		

REVISIONS:

THEATER OF OPERATIONS.
FORT DAWES - BOSTON HARBOR, MASS.

POST EXCHANGE.

U.S. ENGINEER OFFICE, BOSTON, MASS. NOV. 1942

APPROVAL RECOMMENDED — CHIEF WAR AND FLOOD CONTROL SUBDIVISION.
SUBMITTED — CHIEF, DESIGN SECTION, SR ENGINEER.
ASSOCIATE ENGINEER
DES. BY
DR. BY HEY.
TR. BY
CH. BY

APPROVED — COLONEL CORPS OF ENGINEERS DISTRICT ENGINEER.

FILE NO. X100-103/21.3

127