WAR DEPARTMENT

CORPS O

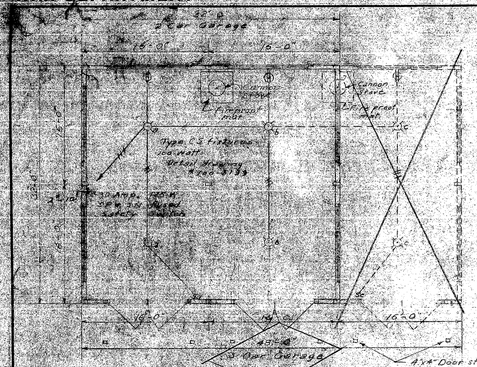

2 CAR BUILT.
FLOOR PLAN
SCALE 1/8"=1'-0"

For heated garage:
1 space heater for 2 Car garage
2 space heater for 3 Car garage

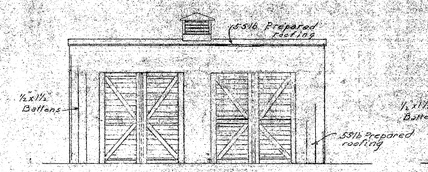

ELEVATION
2 CAR GARAGE
SCALE 1/8"=1'-0"

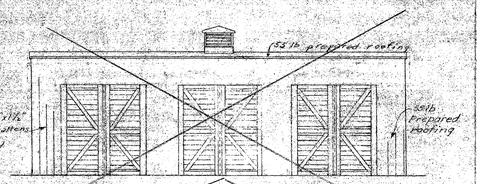

ELEVATION
3 CAR GARAGE
SCALE 1/8"=1'-0"

2 CAR BUILT.

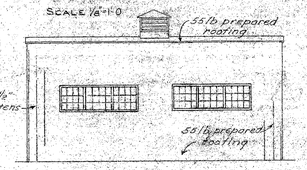

REAR ELEVATION
2 CAR GARAGE
SCALE 1/8"=1'-0"

SECTION A-A
SCALE 3/4"=1'-0"

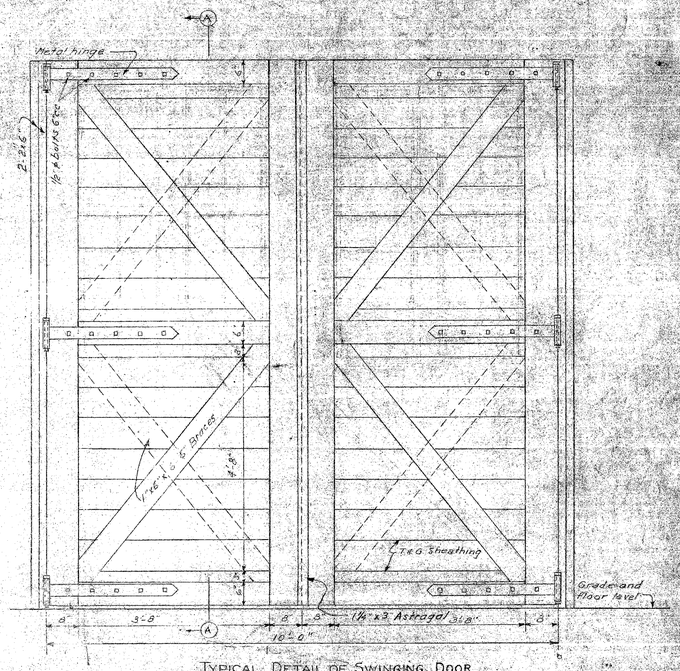

TYPICAL DETAIL OF SWINGING DOOR
SCALE 3/4"=1'-0"

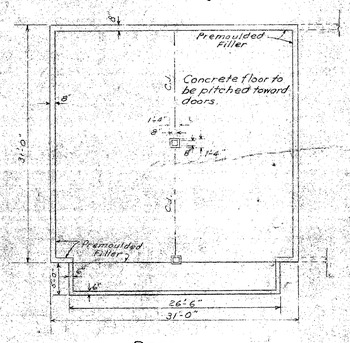

DETAIL
FOUNDATION PLAN
SCALE 1/8"=1'-0"

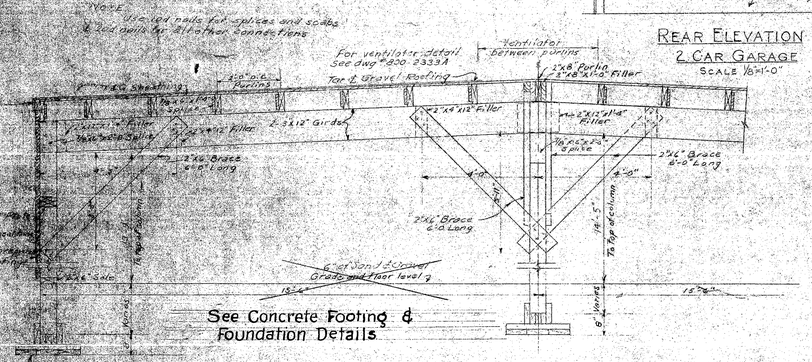

TRANSVERSE SECTION
SCALE 1/2"=1'-0"

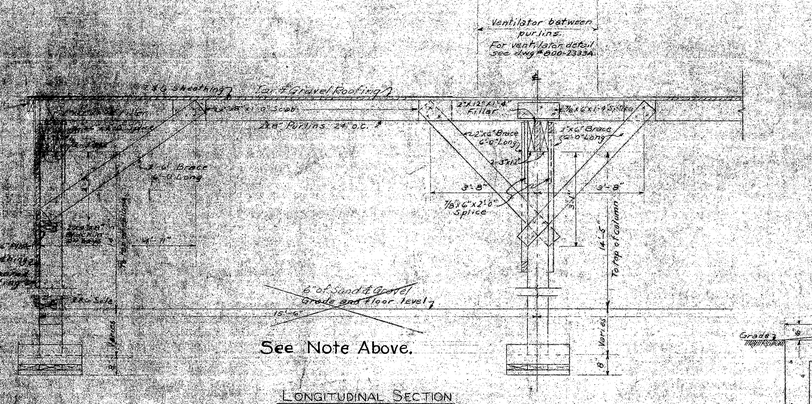

LONGITUDINAL SECTION
SCALE 1/2"=1'-0"

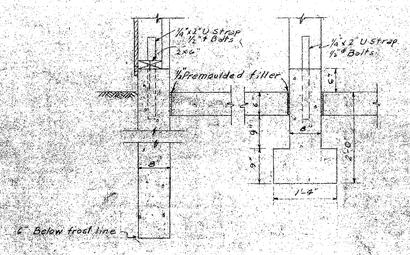

DETAIL
CONCRETE FOOTING
SCALE 3/4"=1'-0"

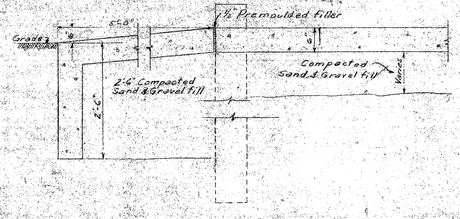

DETAIL
CONCRETE RAMP
SCALE 3/4"=1'-0"

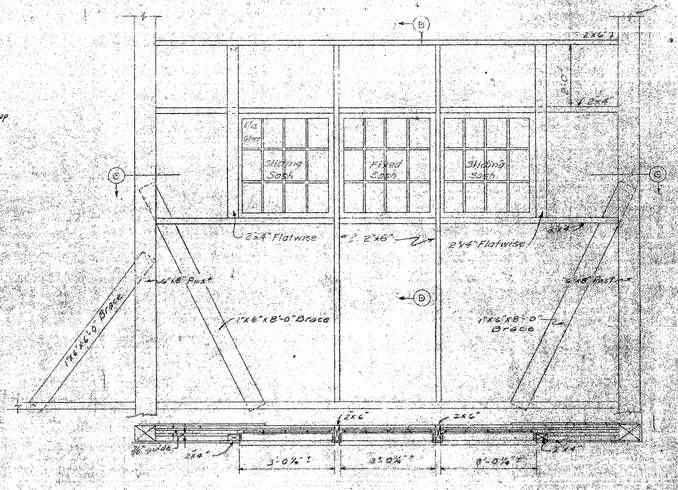

SECTION C-C

DETAIL OF WINDOWS
SCALE 1/2"=1'-0"

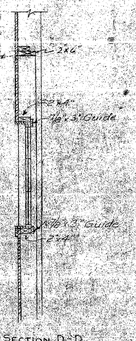

SECTION D-D

RECORD DRAWINGS

Note:
If heated building is specified ½" insulation to be placed between studs and sheathing & roofing and sheathing.

Record Dwg: No Changes. 7/24/46 RMP

NO.	CHARACTER	DATE	BY

REVISIONS

THEATER OF OPERATIONS
2 CAR GARAGE 32'x32'
FORT DAWES, BOSTON HARBOR, MASS.
PLAN, ELEVATIONS, SECTIONS & DETAILS
SCALE AS SHOWN

U. S. ENGINEER OFFICE, BOSTON, MASS. NOV. 1942

APPROVAL RECOMMENDED: APPROVED:
CHIEF, RIVER AND FLOOD CONTROL DIVISION
SUBMITTED:
CHIEF DESIGN SECTION, RR. ENGINEER
ASSISTANT ENGINEER

DESIGN BY
DR. BY
TR. BY
CH. BY

FILE NO. X100-103/39.1