WAR DEPARTMENT

CORPS

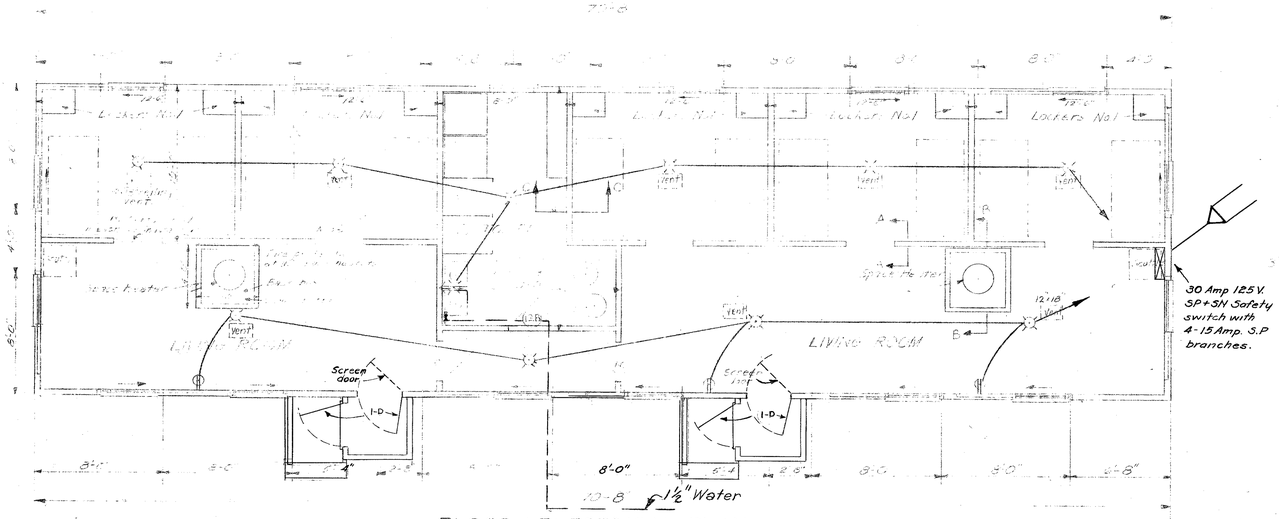

FLOOR & ELECTRICAL PLAN

SCALE 1/4 = 1'-0"

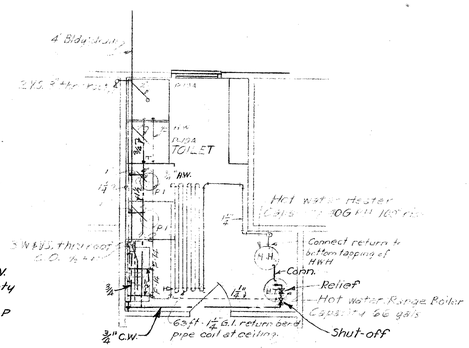

PLUMBING LAYOUT

SCALE 1/4 = 1'-0"

PLUMBING SYMBOLS

Drain
Vent — V.
Cold water — C.W.
Hot water — H.W.
Cleanout — C.O.

NOTE:
All ceiling outlets to have 60 Watt type APS fixtures with mounting height at 7'-0".
Bracket light in toilet shall be 50 Watt type COS fixture.
For details of electrical fixtures, see specifications.
Service entrance equipment to be located to suit existing exterior distribution facilities.

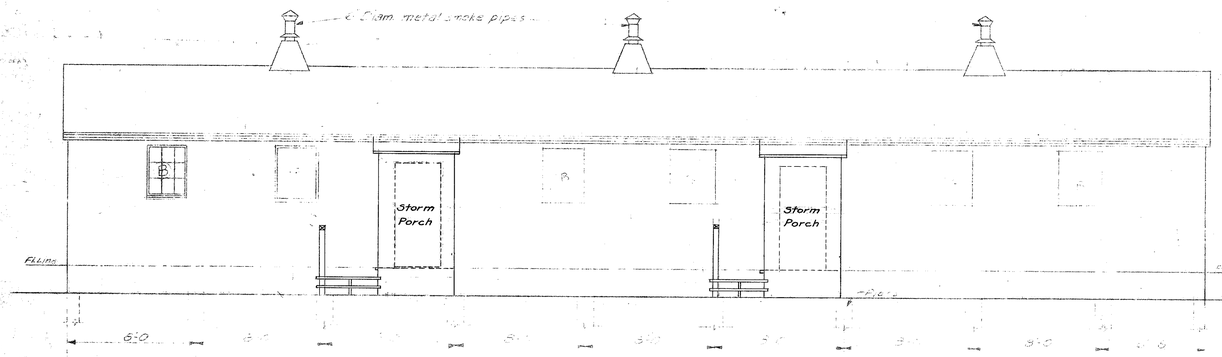

FRONT ELEVATION

SCALE 1/4 = 1'-0"

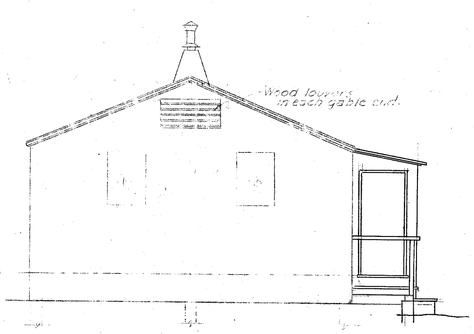

LEFT SIDE ELEVATION

SCALE 1/4 = 1'-0"

GENERAL NOTES

1. Dimensions are to outside face of studs for ext. walls & center to center of stud for partitions.
2. All window sills shall be sloped on outside.
3. Provide [illegible] brackets to hang on exterior wall.
4. Location & location [illegible] shall be as directed by Chief Engineer.
5. All [illegible] shall be [illegible] end, 10'-0" max., fixed on one side with wall brackets unless otherwise noted or shown.
6. Partition noted to underside of roof to top of underside of [illegible] ceiling to roof rafters when ceiling is required.
7. Drawing indicates finished grade as level. When bldg. is located on sloping ground, see Dwg. T.O. 700-5002YY, for details of foundation, etc.
8. Space heaters shall be Army #1.
9. Extend partitions between rooms to floor.

DRAWING NUMBERS

Dwg. No.	TITLE	DET. Nos.
T.O. 700-5001YY	Standard framing details	as required
T.O. 700-5164	Standard door detail	" "
T.O. 700-5165	Standard miscellaneous details	1-5-5-6
T.O. 700-5166	Standard miscellaneous details	1-5-10
T.O. 700-5169	Standard electrical details	as required
T.O. 700-5167	Standard plumbing details	" "
T.O. 700-5157X	Vestibule details	

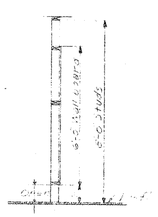

TYPICAL SECTION A-A

SCALE 1/4 = 1'-0"

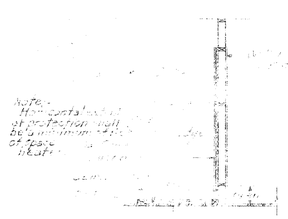

TYPICAL SECTION B-B

SCALE 1/4 = 1'-0"

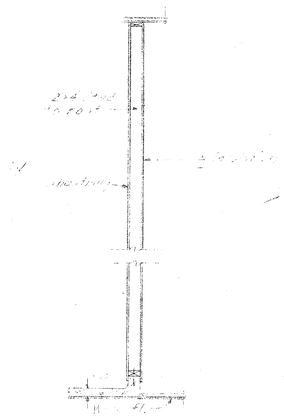

TYPICAL SECTION C-C

SCALE 1/4 = 1'-0"

RECORD DRAWINGS

NO.	CHARACTER	DATE	BY
3.	Water lines, plumbing (As built)	1/6/44	B.K.
2.	Entrances, Elect. connections (As built)	12/8/43	R.B.T.
1.	Foot prints, partitions, [illegible]	11/14/43	R.D.M.

REVISIONS

THEATER OF OPERATION
OFFICERS QUARTERS
TYPE O.Q.A-T MOD. 10 MEN

FLOOR ELECTRICAL PLUMBING PLANS & ELEV.
FORT DAWES, BOSTON
SCALES AS SHOWN

U. S. ENGINEER OFFICE, BOSTON, MASS. DEC. 1942.

APPROVAL RECOMMENDED:
CHIEF, WAR AND FLOOD CONTROL DIVISION

SUBMITTED:
CHIEF, DESIGN SECTION, SR. ENGINEER

DES. BY
DR. BY T.Q.
TR. BY
CH. BY

APPROVED:
COLONEL, CORPS OF ENGINEERS
DISTRICT ENGINEER

FILE NO. X100-102A/10

FORMERLY X100-102A/10