X-128706

REF	PART NO.	NAME OF PART	MAT.	MATERIAL SPEC.	PATT. NO.	
1		STOP-OFF PLATE	ST	M-7211	3/16" x 60 x 96 GALVANIZED	1
2		2" UNIT THREADED CINCH ANCHORAGE		BURDIN NATL. CORP.		12
3		3/8" UNIT THREADED CINCH ANCHORAGE		" "		4
4		1/2" UNIT THREADED CINCH ANCHORAGE		" "		4
5	80842	1/4" TAP BOLT x 1 1/16"	ST	M-4206		12
6	80873	3/8" TAP BOLT 2 1/4" LG.	ST	M-4206		4
7	80922	1/2" TAP BOLT x 2 3/4"	ST	M-4206		4
8	80862	BOLT 3/8" x 3/4"	ST.	M-4206		16
9	80863	BOLT 3/8" x 7/8"	ST	"		2
10	81507	NUTS 3/8"	ST	"		8

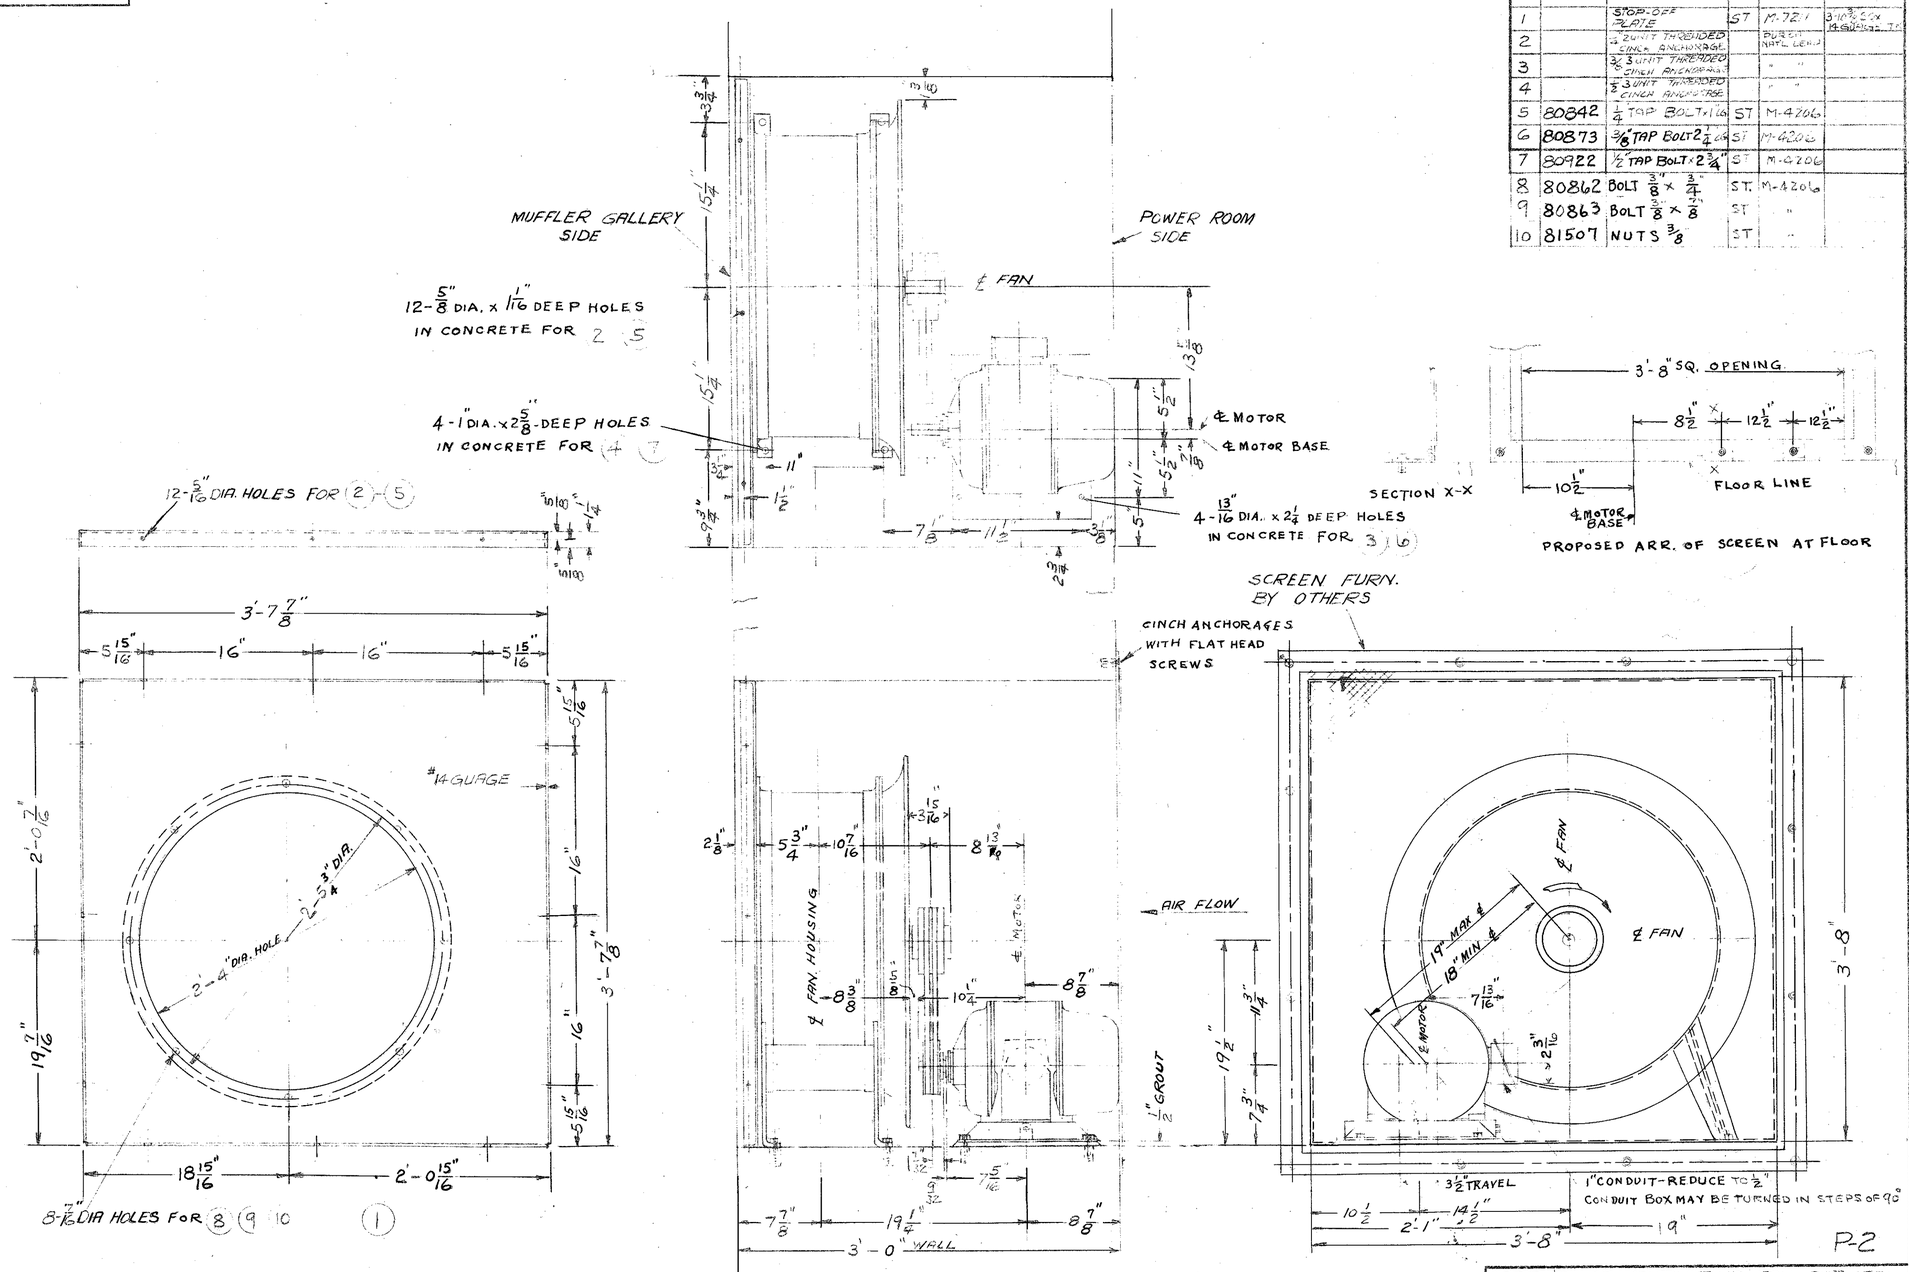

FOR 27" FAN SEE B.F. STURTEVANT Co's. PRINT DRAWING NO. L15-16585-A
3HP. WESTINGHOUSE F.C. EX. PROOF MOTOR-FRAME NO. 225

FILE NO. 4-7-4:11/41

BATTERY NO. 105-1

APPROVED FOR CHIEF OF ORDNANCE

PRINCIPAL ENGINEER - OFFICE CHIEF OF ORDNANCE

ARRGT. OF VENTILATING FAN BETWEEN ENG ROOM & MUFFLER GALLERY FOR BATT.

WORTHINGTON PUMP AND MACHINERY CORPORATION
BUFFALO, NEW YORK

ORDER EG-6525 DATE 1-20-43 SCALE 1/2 INS. - 1 FOOT

DRAWN	CHECKED	APPROVED	
JJJ	JES		X-128706A

1-25-43

ADDED STAMP OF APPROVAL REQ BY ORD. DEPT 2-18-43 JJJ

RECORD DRAWING

B. B. P. CO.

5