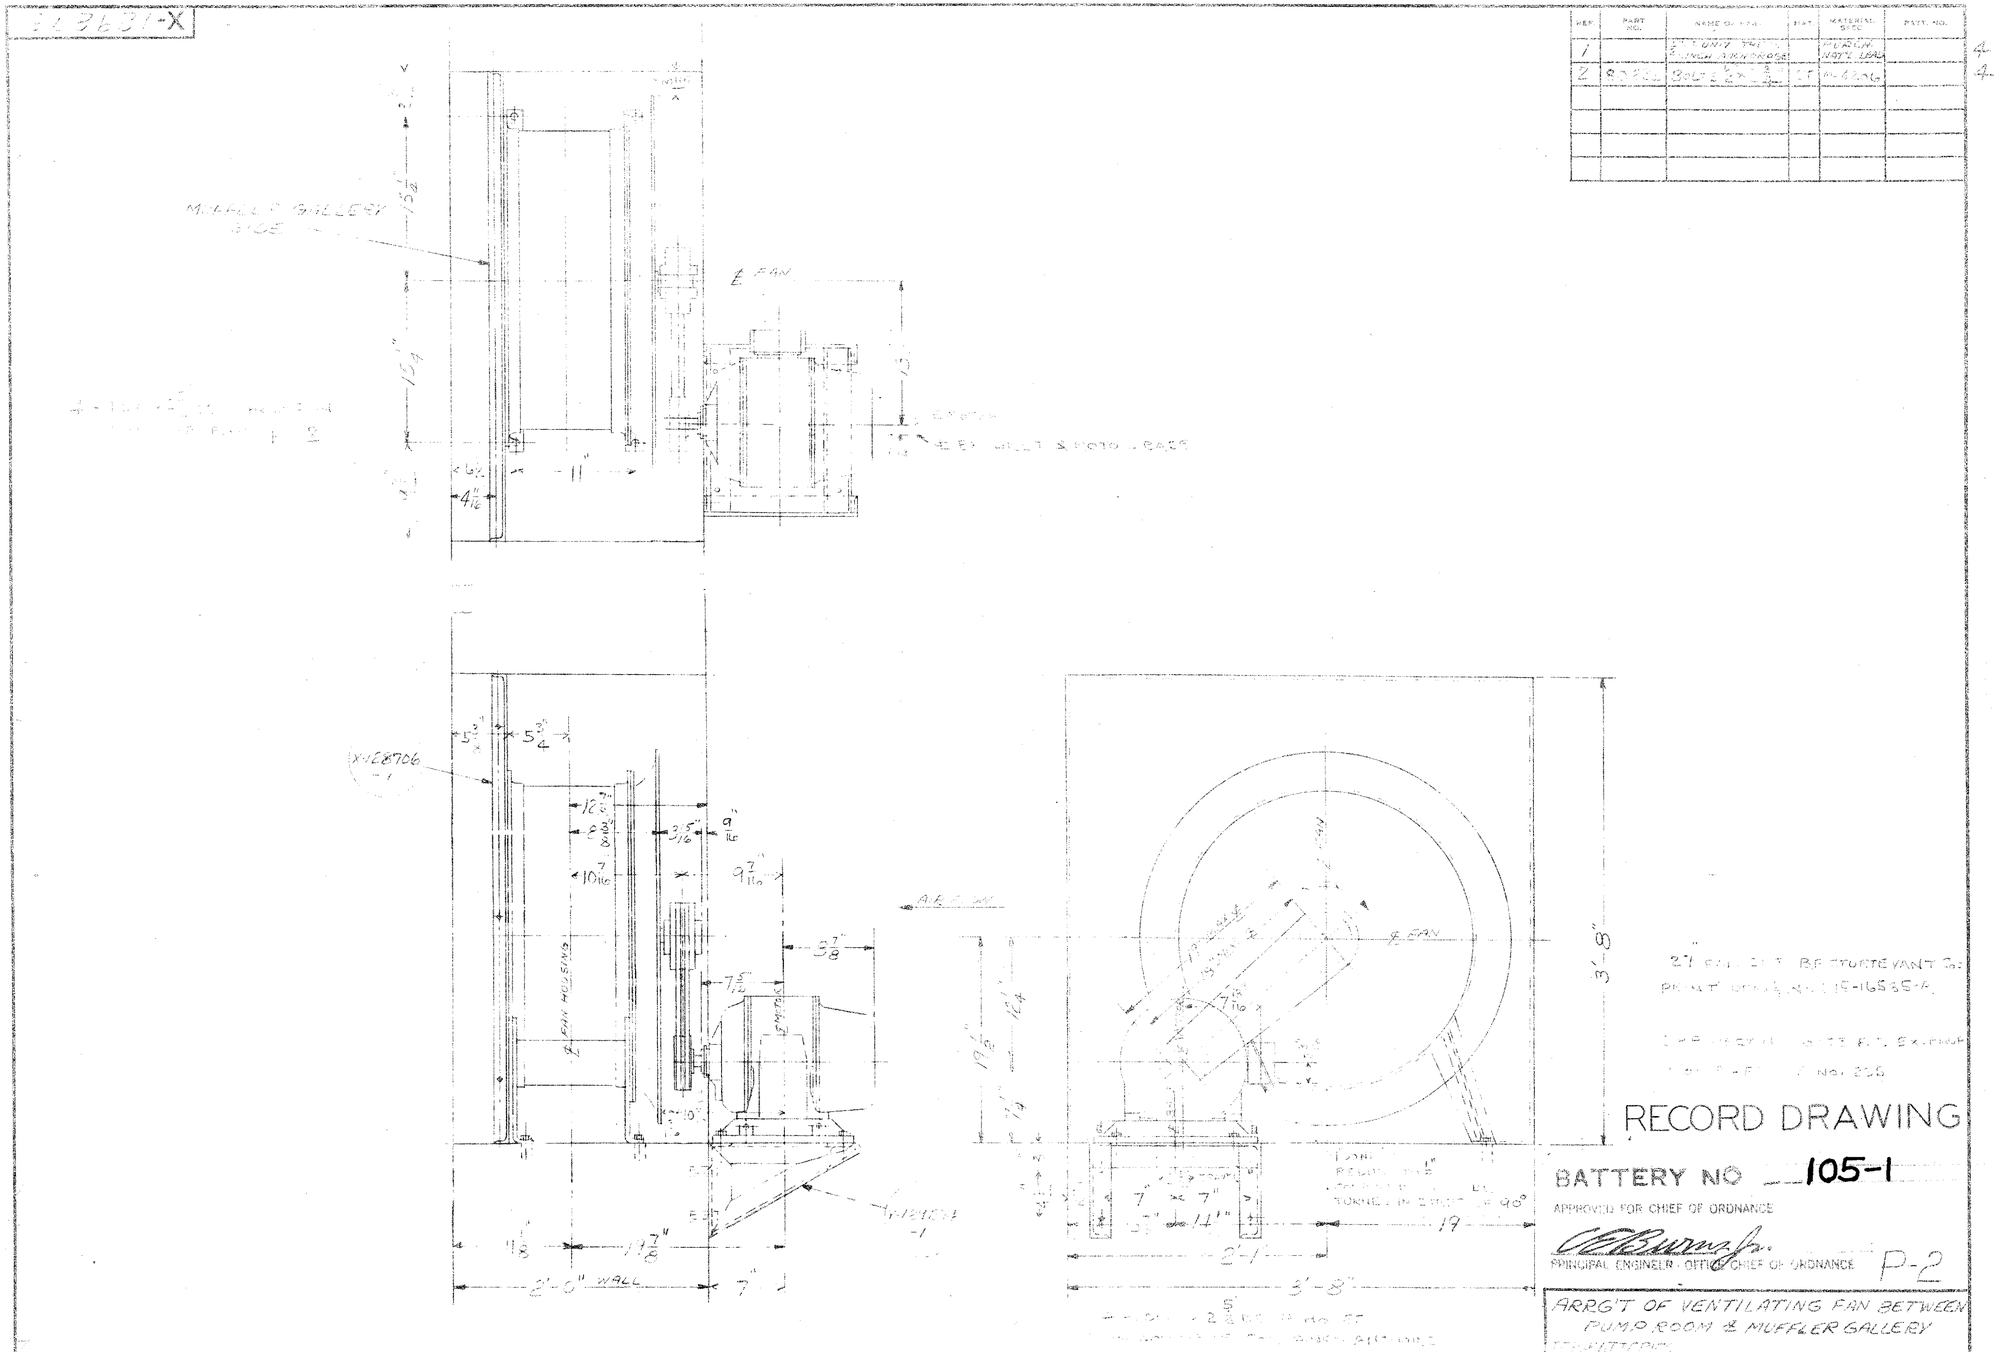

REF.	PART NO.	NAME OF PART	MAT.	MATERIAL SPEC.	PART NO.
1		[illegible] UNIT TRUE [illegible] INCH ANCHORAGE		PURCH. NAT'L LEAD	4
2	[illegible]	BOLT [illegible]	[illegible]	M-4206	4

27" [illegible] BP STORTEVANT [illegible]
PRINT [illegible] 15-16535-A

[illegible] EX. PROP
[illegible] No. 225

RECORD DRAWING

BATTERY NO 105-1

APPROVED FOR CHIEF OF ORDNANCE

C. E. Burns Jr.
PRINCIPAL ENGINEER - OFFICE CHIEF OF ORDNANCE

P-2

ARRG'T OF VENTILATING FAN BETWEEN PUMP ROOM & MUFFLER GALLERY

FILE NO. 4-7-4-11/44

Tolerances For Detail Drawings:
Finished fractional dimensions where no limits given ± 1/64"
" decimal " " " " " ± .005"
Where closer tolerances required limits are specified.
This note does not apply to elevations.

WORTHINGTON PUMP AND MACHINERY CORPORATION
BUFFALO, NEW YORK

ORDER EG-6525 DATE 1-21-43 SCALE 1 1/2 INS. - 1 FOOT

DRAWN	CHECKED	APPROVED	
R.W.D.	[illegible]		X-129273-A