W-129094

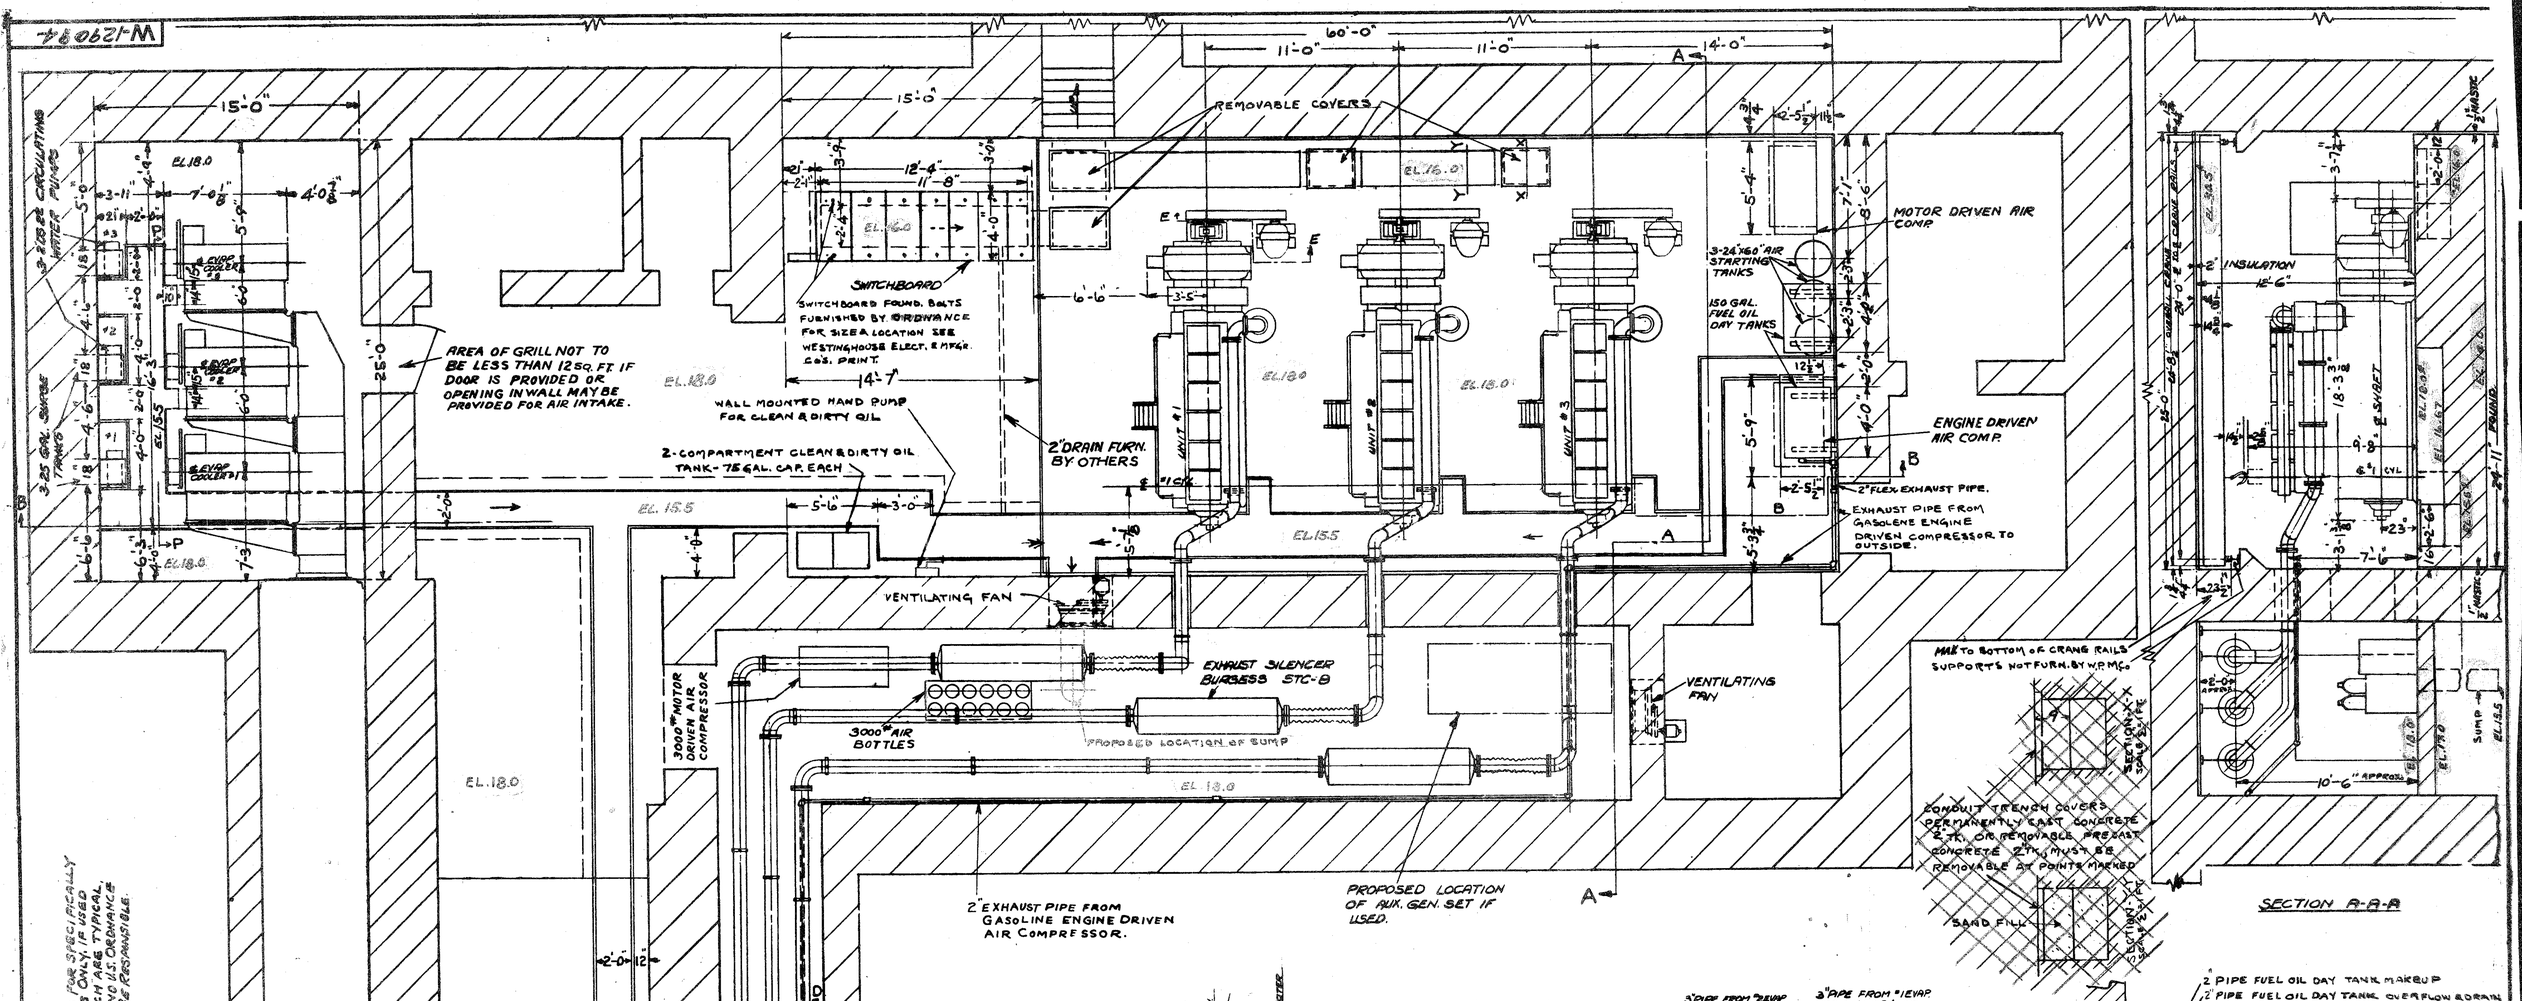

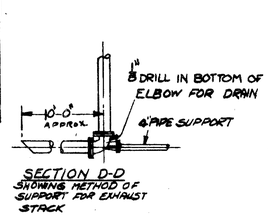

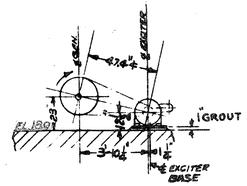

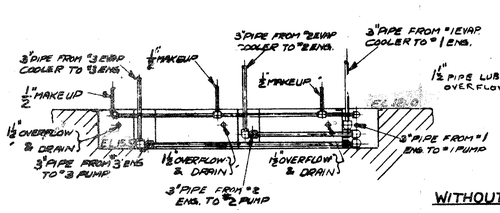

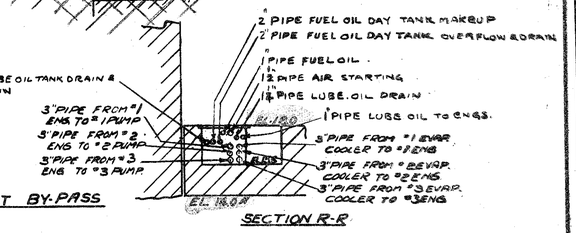

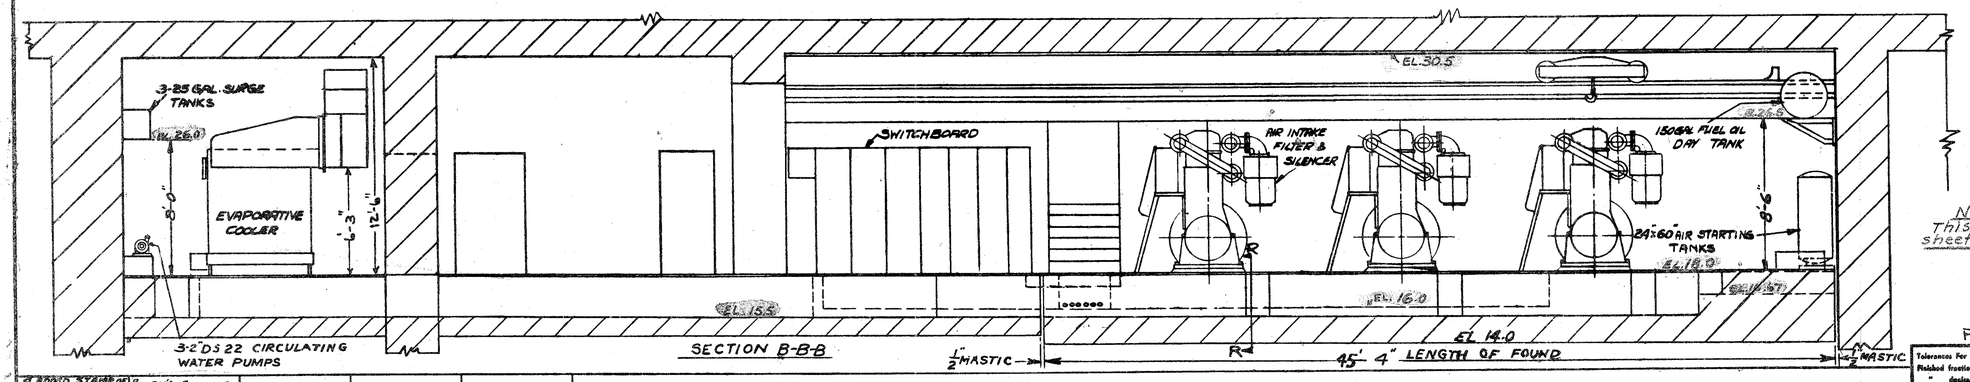

NOTE: THIS DRAWING IS FOR SPECIFICALLY NOTED BATTERIES ONLY IF USED FOR OTHERS WHICH ARE TYPICAL W.P.& M.Co. & NO ORDNANCE DEPT. WILL NOT BE RESPONSIBLE.

FOR ARRGT OF FOUND SEE W-129095-B
FOR ARRGT OF ENG. SEE W-128444
FOR ARRGT OF REINFORCING RODS SEE X-129096-A
FOR ARRGT. OF CONDUITS SEE W-129097-B

NOTE:- ALL TRENCH COVERS & SUPPORTS TO BE FURNISHED BY OTHERS

NOTE: STEEL PLATE PROPOSED FOR TRENCH COVERS AT ALL POINTS WHERE PIPES ENTER TRENCHES

NOTE: ARROWS INDICATE DIRECTION OF SLOPE FOR DRAIN SEE ALSO

RECORD DRAWING
BATTERY NO. 105
APPROVED FOR CHIEF OF ORDNANCE
PRINCIPAL ENGINEER - OFFICE CHIEF OF ORDNANCE

Note: This sheet supersedes sheet W-129094-A

P-2

FILE NO. 4-7-4-11/45

Tolerances For Detail Drawings:
Finished fractional dimensions where no limits given ± 1/64"
" decimal " " " " " ± .005"
Where closer tolerances required limits are specified.
This note does not apply to deviations.

STATION ARRANGEMENT OF 3-10 3/4"x14 1/2" CCGs VERT. DIESEL ENGINE FOR BATTERY

WORTHINGTON PUMP AND MACHINERY CORPORATION
BUFFALO, NEW YORK

ORDER EG-6525 DATE 11-27-42 SCALE 1/8 INS. = 1 FOOT

DRAWN	CHECKED	APPROVED	W-129094-B
JJJ	JES		

11-28-42

A. ADD'D STAMP OF APPROVAL REQ. BY ORD. DEPT. & NOTE FOR G FELL. 2-18-43 J.J.J.

B - CH'D. EXHAUST PIPING TO OUTSIDE ON GAS. DRIVEN AIR COMP. 4-27-43