W-129359

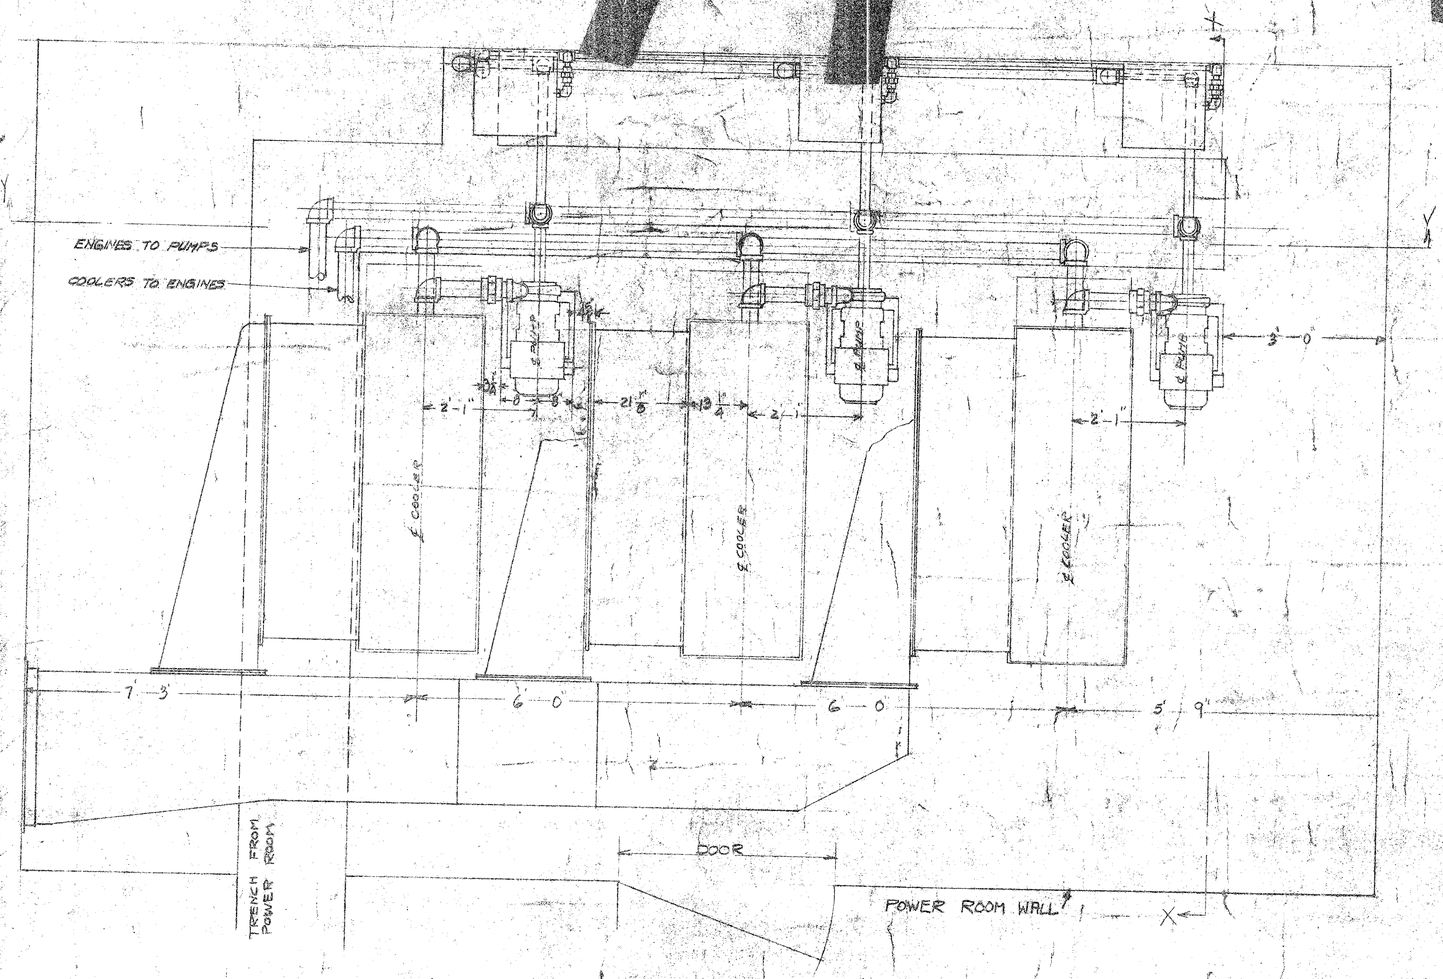

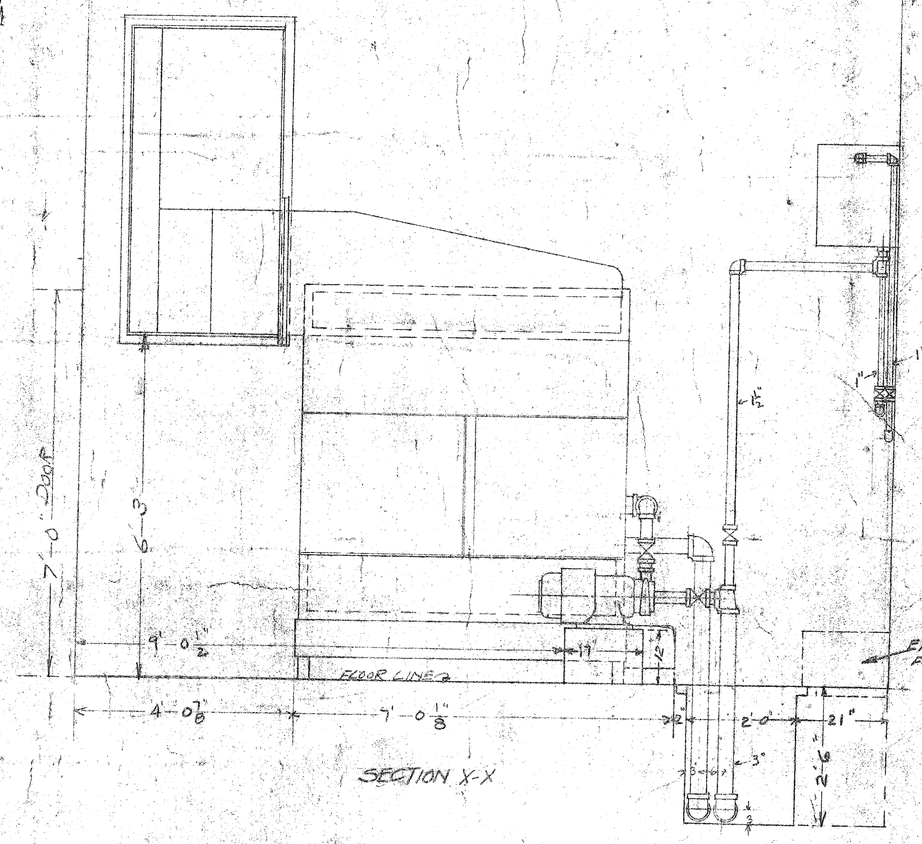

SECTION X-X

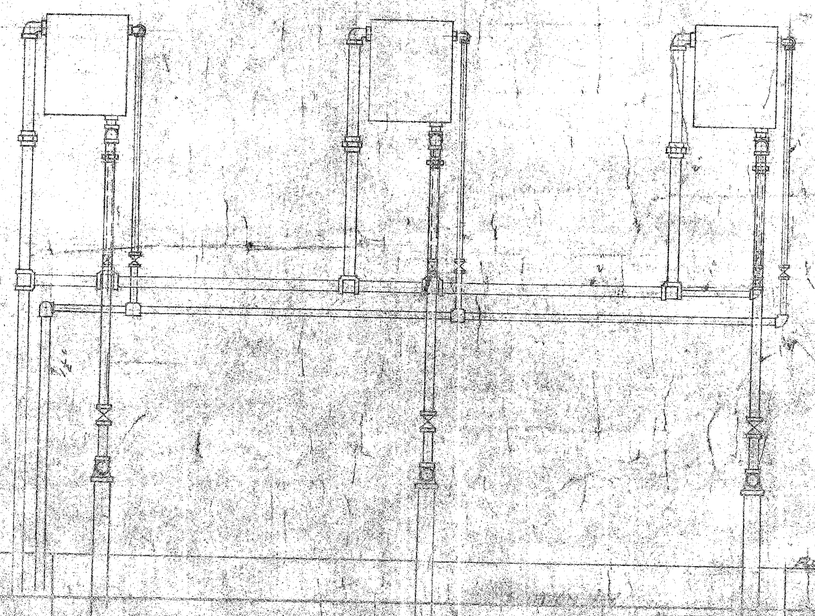

NOTE:-
SUCTION DUCTS WHEN USED TO BE BUILT AROUND MOTORS.

RECORD DRAWING

FILE NO. 4-7-4-11/48

APPROVED FOR CHIEF OF ORDNANCE

C.E. Burnett

PRINCIPAL ENGINEER - OFFICE CHIEF OF ORDNANCE

ALTERNATE PLAN FOR PLACING OF JACKET WATER PUMPS FOR U.S. ORDNANCE PLANT

THOMPSON PUMP AND MFG. CO. INC. PORTLAND, OREGON