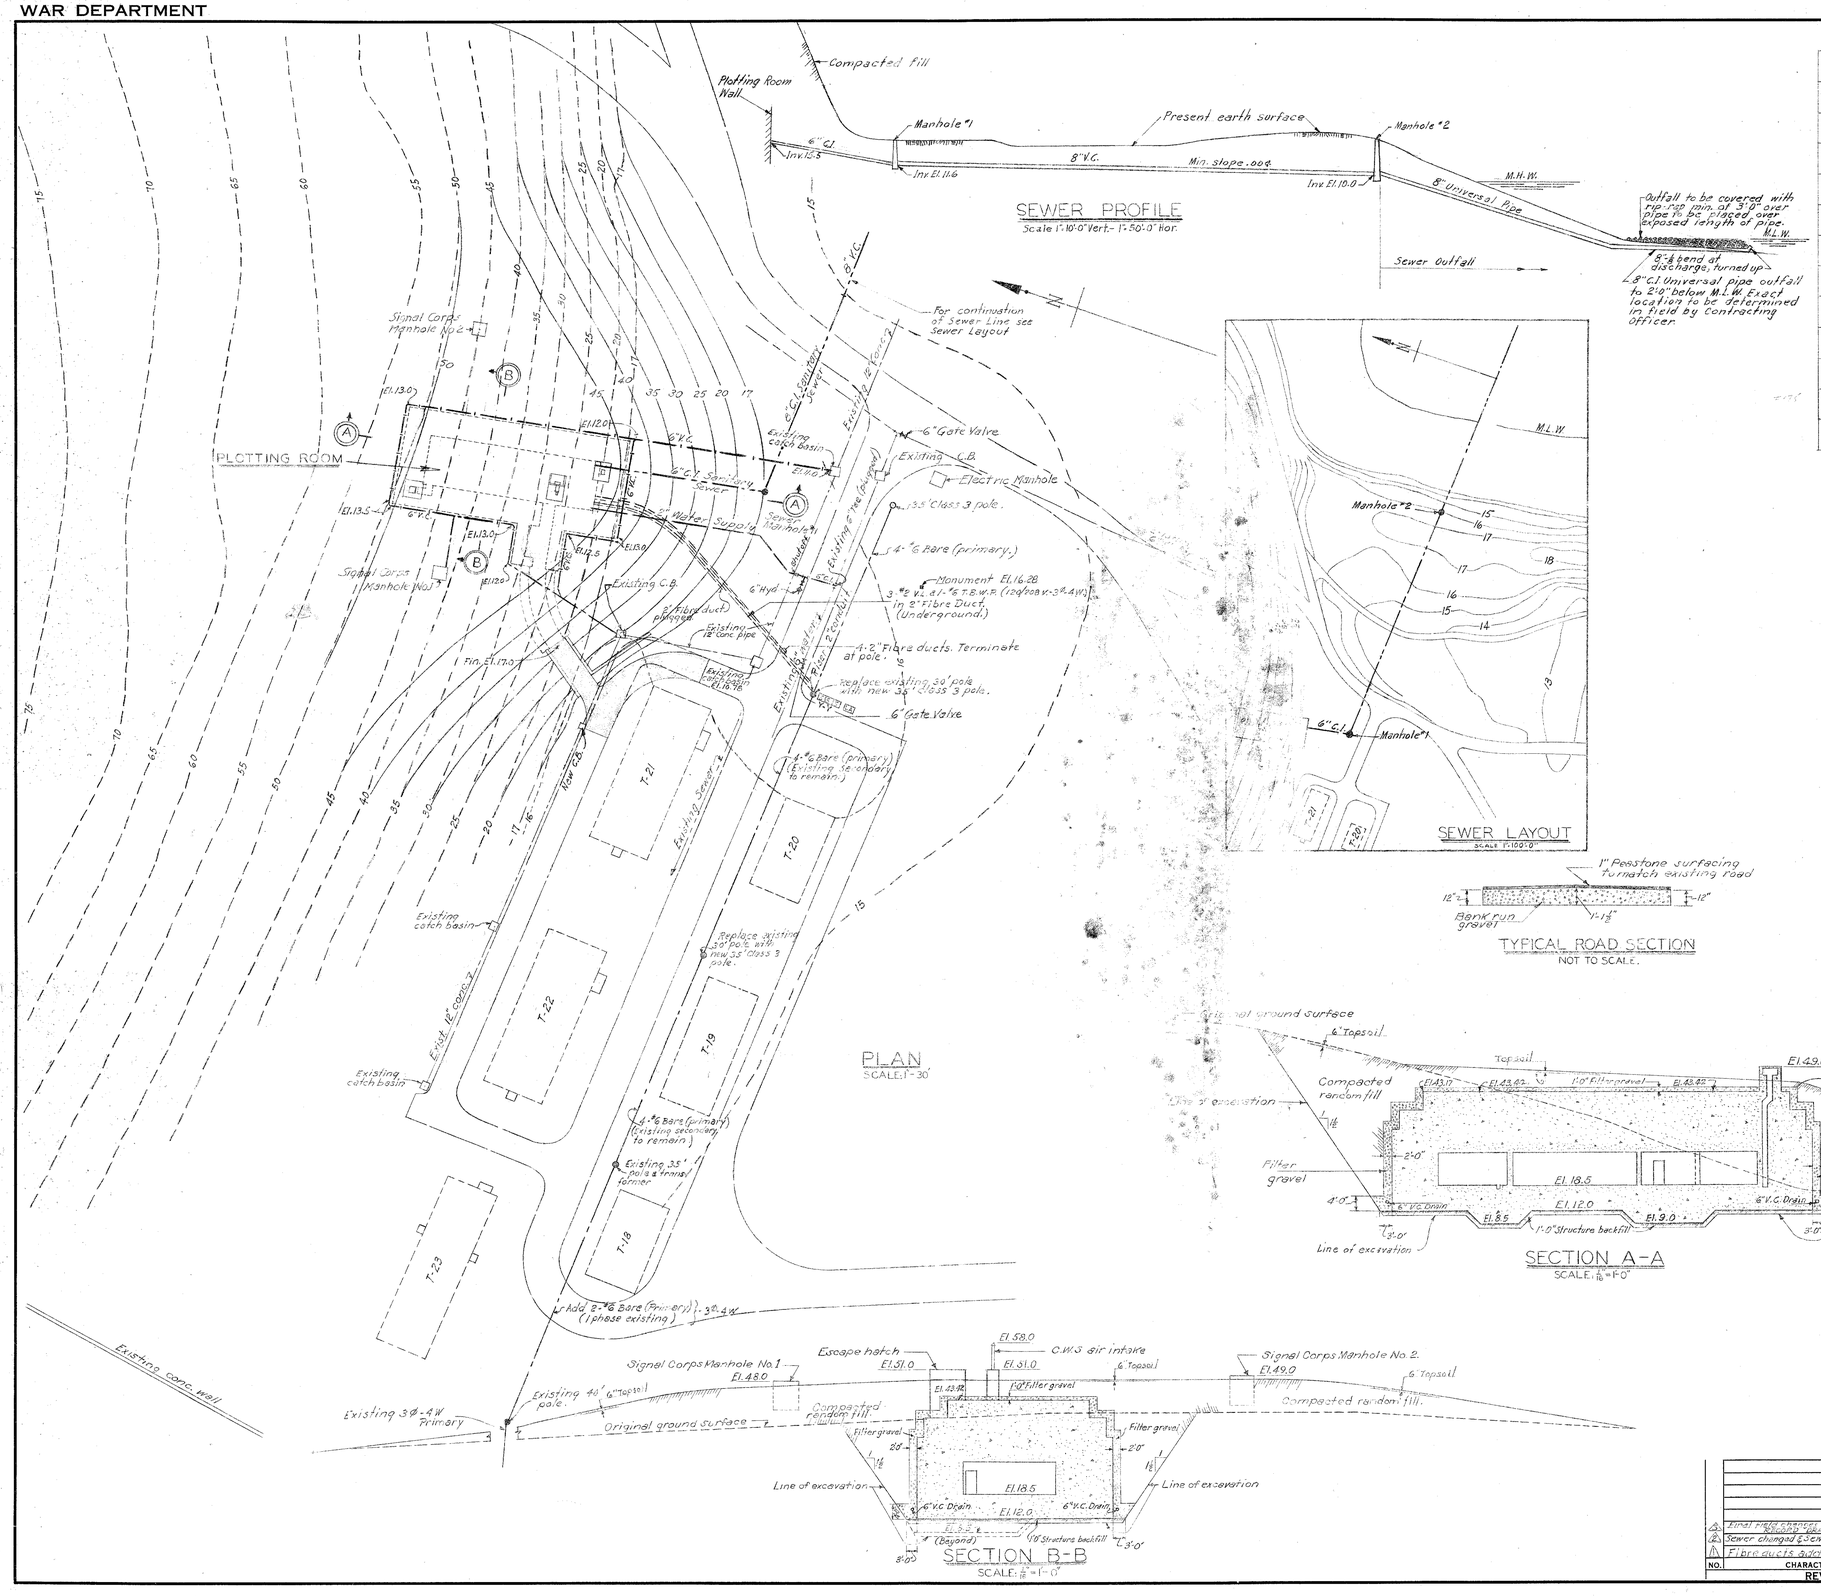

INDEX

SH. NO.	DESCRIPTION	SH. NO.	DESCRIPTION
1.	GENERAL LOCATION PLAN & INDEX.	11.	ROOF PLAN & SECTIONS - NO. 2. REINFORCEMENT.
2.	EXCAVATION PLAN & SECTIONS EXPLORATION DATA	12.	CONDUIT & DUCT LAYOUT & SECTIONS MANHOLE & HANDHOLE DETAILS
3.	PLAN OF TOP OF FOUNDATION MAT FLOOR SLAB DETAILS & REINFORCMT.	13.	MISCELLANEOUS DETAILS
		13A.	GASPROOF VALVE DETAIL
4.	DRAINAGE, PLUMBING, SEWERAGE & WATER LAYOUTS - PLAN & SECTIONS.	14.	DEHUMIDIFYING & GASPROOFING SYSTEMS - PLAN & SECTIONS.
5.	MASONRY PLAN & SECTIONS - NO. 1.	15.	ELECTRICAL LAYOUT.
6.	MASONRY PLAN & SECTIONS - NO. 2.	16.	DOOR DETAILS - NO. 1.
7.	FOUNDATION PLAN & SECTS. - PART 1 & 2 - REINFORCEMENT.	17.	DOOR DETAILS - NO. 2.
8.	FOUNDATION PLAN & SECTS. - PART 3. REINFORCEMENT.	18.	DOOR DETAILS - NO. 3.
9.	WALL PLAN, ELEVATIONS & SECTIONS, REINFORCEMENT.		
9A	ENTRANCE STRUCTURE & WING WALLS PLAN & SECTS. - REINFORCEMENT		
10	ROOF PLAN & SECTIONS - NO. 1. REINFORCEMENT.		

Note: Recorded field changes have been made on all sheets where they occur.

LEGEND

Existing buildings shown thus
Existing contours shown thus
Finished contours shown thus
Existing roads shown thus
New road shown thus
Existing water line shown thus
New water line shown thus
New drainage lines (open joint) shown thus
New drainage lines (closed joint) shown thus
Existing sanitary sewer line shown thus
New sanitary sewer line shown thus
Hydrant shown thus
New sewer manhole shown thus
Existing drainage line shown thus
New pole location shown thus
Existing pole location shown thus
Transformer shown thus — S
Lightning arrester (600 volt secondary) shown thus — LA

NOTES:

For location of Plotting Room see sheet File No. 127/1
Elevations are in feet and refer to the plane of Mean Low Water.
Elevations of Sewer, Water and Drainage lines refer to invert.
See Sheet No. 4 for continuation of Sewer, Water and Drainage lines.
See Sheet No. 12 for continuation of Fibre Ducts.

New road shall match and blend into existing road.
See sheet No. 5 for General Notes.

Topsoil shall be placed to a depth of 6 inches over entire area within limits of Finished Contours, and shall form the Finished Contours.

NO.	CHARACTER	DATE	BY
3	Final record changes made for "Record" drawing	10-18-43	P.H.W.
2	Sewer changed & cover profile added	7-9-43	P.H.W.
1	Fibre ducts added	6-21-43	P.H.W.

REVISIONS

CONFIDENTIAL

RECORD DRAWING

HARBOR DEFENSES OF BOSTON

BATTERY NO. 105

PLOTTING ROOM

GENERAL LOCATION PLAN & INDEX

IN 20 SHEETS — SHEET NO. 1. — SCALE AS SHOWN

U. S. ENGINEER OFFICE, BOSTON, MASS. — APRIL, 1943

APPROVAL RECOMMENDED: John E. Allen, CHIEF, ENGINEERING DIVISION

APPROVED: G. W. Lillie, COLONEL, CORPS OF ENGINEERS, DISTRICT ENGINEER

SUBMITTED: J. B. Brown, CHIEF, DESIGN SECTION, SR. ENGINEER

Peter A. Chadbourne, ASSOCIATE ENGINEER

DES. BY
DR. BY C. E. BERAN
TR. BY
CH. BY R. J. B.

FILE NO. 4-7-4-18/1