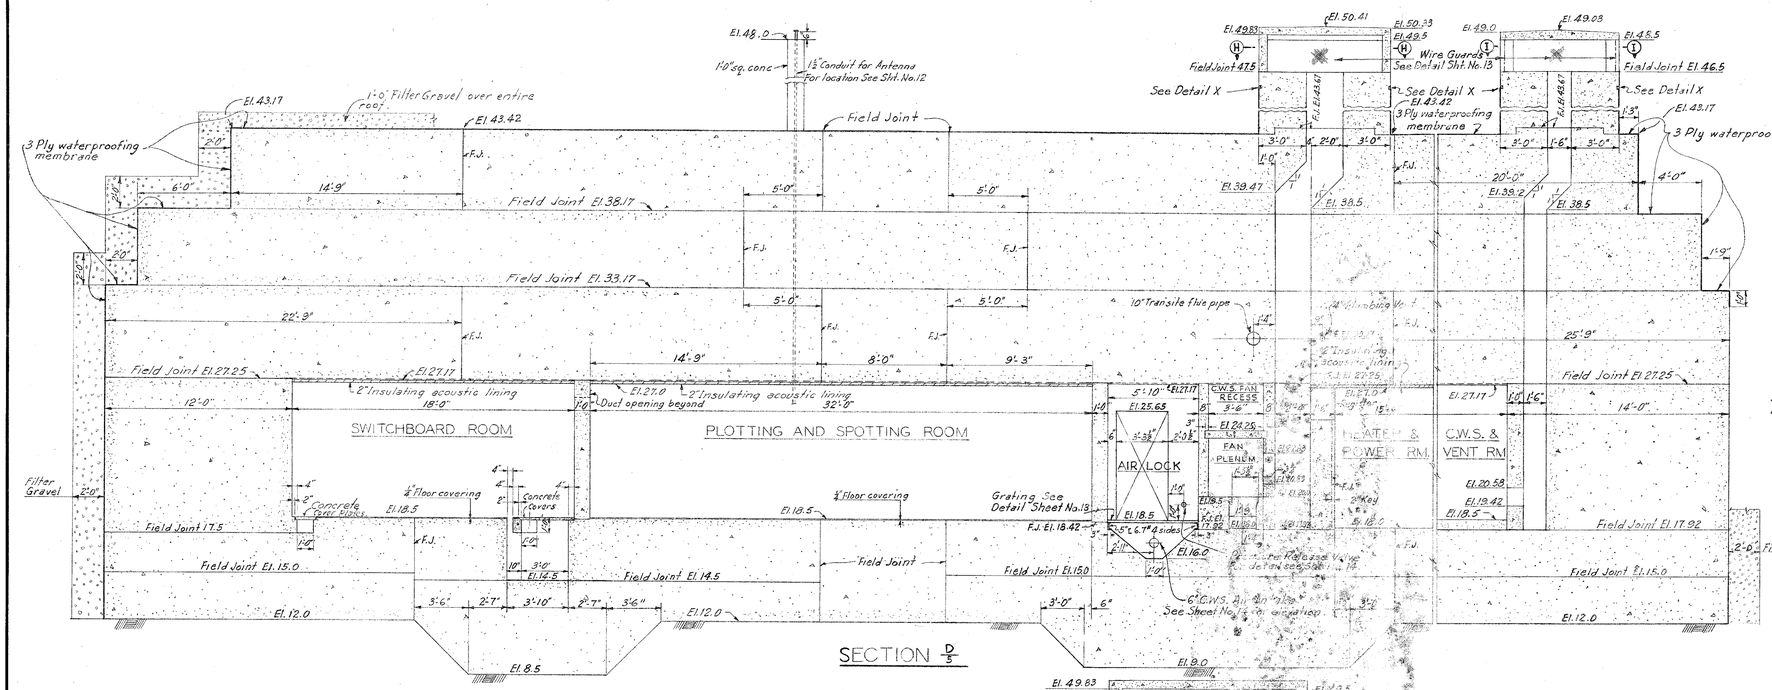

SECTION $\frac{D}{5}$

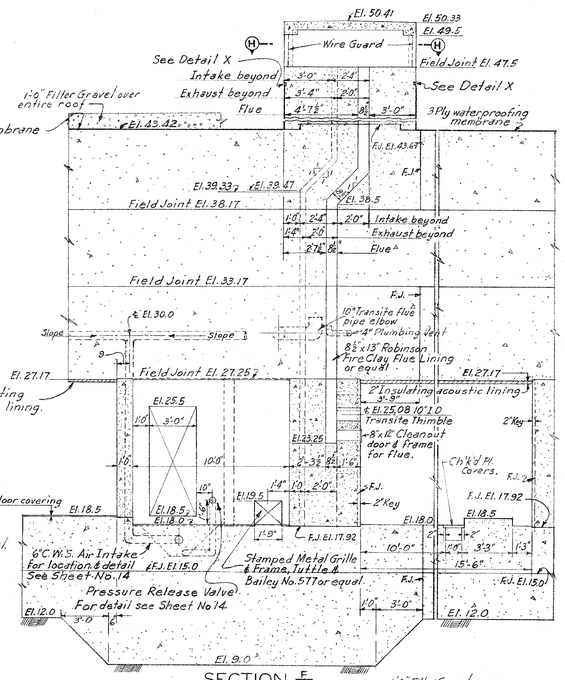

SECTION $\frac{F}{5}$

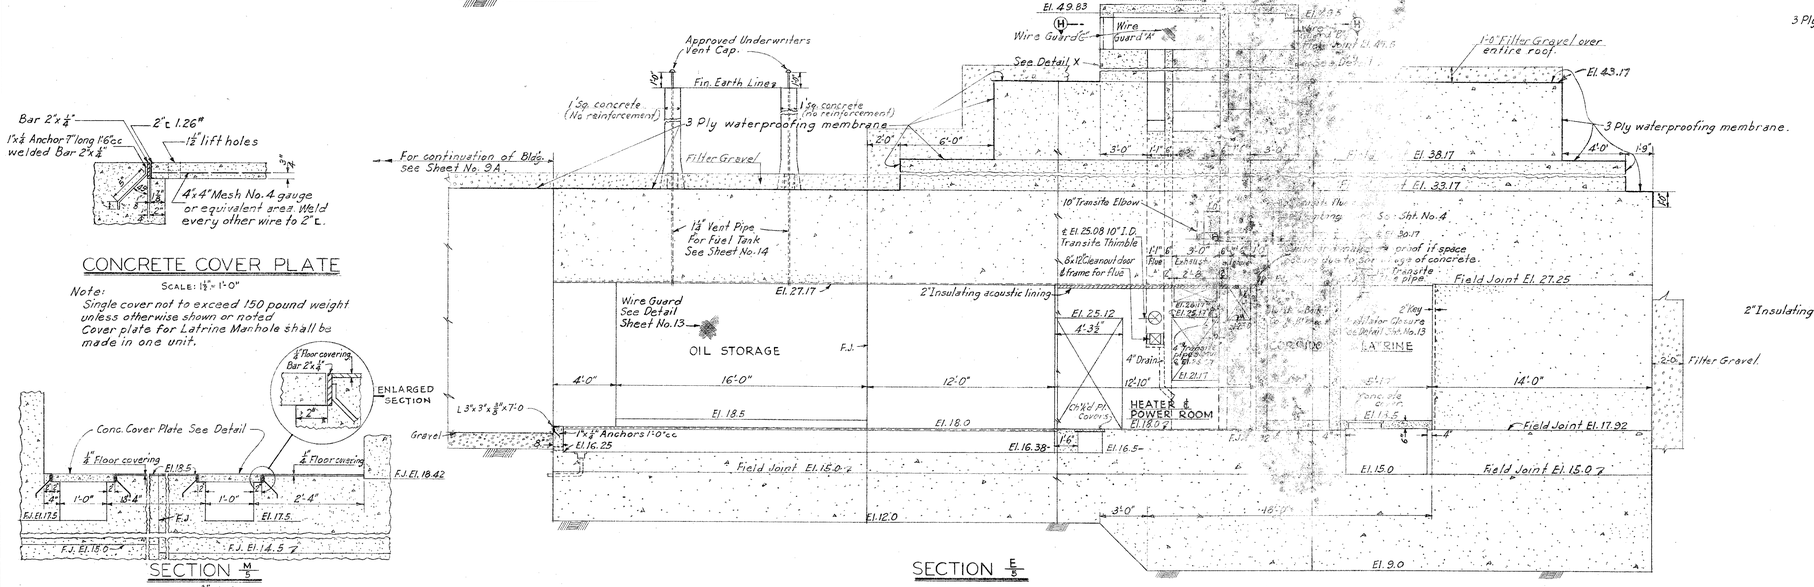

SECTION $\frac{E}{5}$

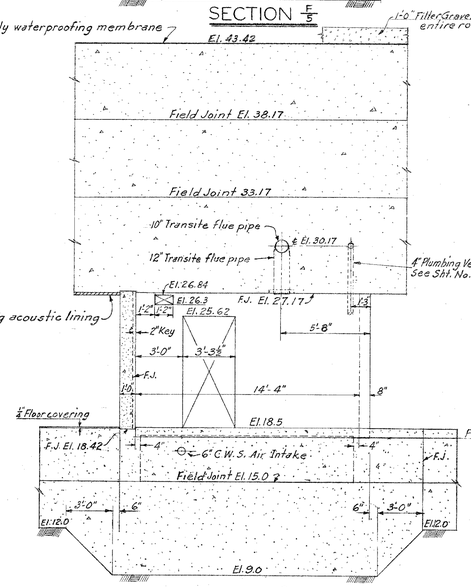

SECTION $\frac{G}{5}$

CONCRETE COVER PLATE

SCALE: 1½" = 1'-0"

Note:
Single cover not to exceed 150 pound weight unless otherwise shown or noted
Cover plate for Latrine Manhole shall be made in one unit.

SECTION $\frac{M}{5}$

SCALE: ¾" = 1'-0"

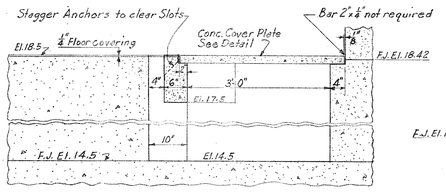

SECTION $\frac{L}{5}$ & $\frac{J}{5}$

SCALE: ¾" = 1'-0"

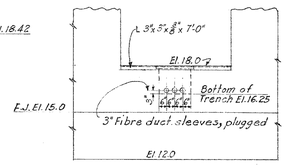

SECTION $\frac{K}{5}$

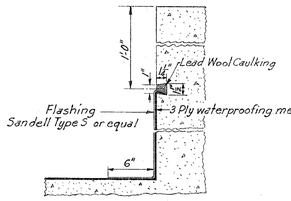

DETAIL X

SCALE: 1½" = 1'-0"

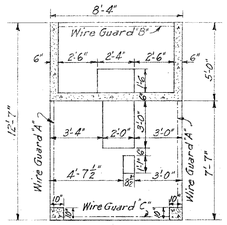

PLAN AT H-H

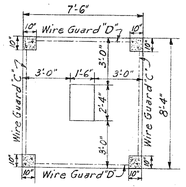

PLAN AT I-I

Notes:
See General Notes Sheet No. 5.
See Sheet No. 13 for formation of concrete at openings for Wire Guards A, B, C & D.

NO.	CHARACTER	DATE	BY
3	Final Field changes made for record drawing	1-15-45	P.A.M.
1	4" Transite sleeve added	6-21-43	P.A.M.

REVISIONS

RECORD DRAWING

CONFIDENTIAL

HARBOR DEFENSES OF BOSTON

BATTERY NO. 105

PLOTTING ROOM

MASONRY PLAN AND SECTIONS NO. 2

IN 20 SHEETS — SHEET NO. 6 — SCALE ¼" = 1'-0"

U. S. ENGINEER OFFICE, BOSTON, MASS. APRIL, 1943

APPROVAL RECOMMENDED: John E. Allen — CHIEF, ENGINEERING DIVISION

SUBMITTED: G. B. Magnum — CHIEF, DESIGN SECTION, SR. ENGINEER

Peter A. O'Malley — ASSOCIATE ENGINEER

APPROVED: G. W. Gilbreth — COLONEL, CORPS OF ENGINEERS, DISTRICT ENGINEER

DES. BY
DR. BY D.E.R.
TR. BY
CH. BY R.J.B.

FILE NO. 4-7-4-18/6

CLASSIFICATION CANCELLED BY AUTHORITY OF 3-4-47

B. L. M., INC.