WAR DEPARTMENT

CORPS OF ENGINEERS, U. S. ARMY

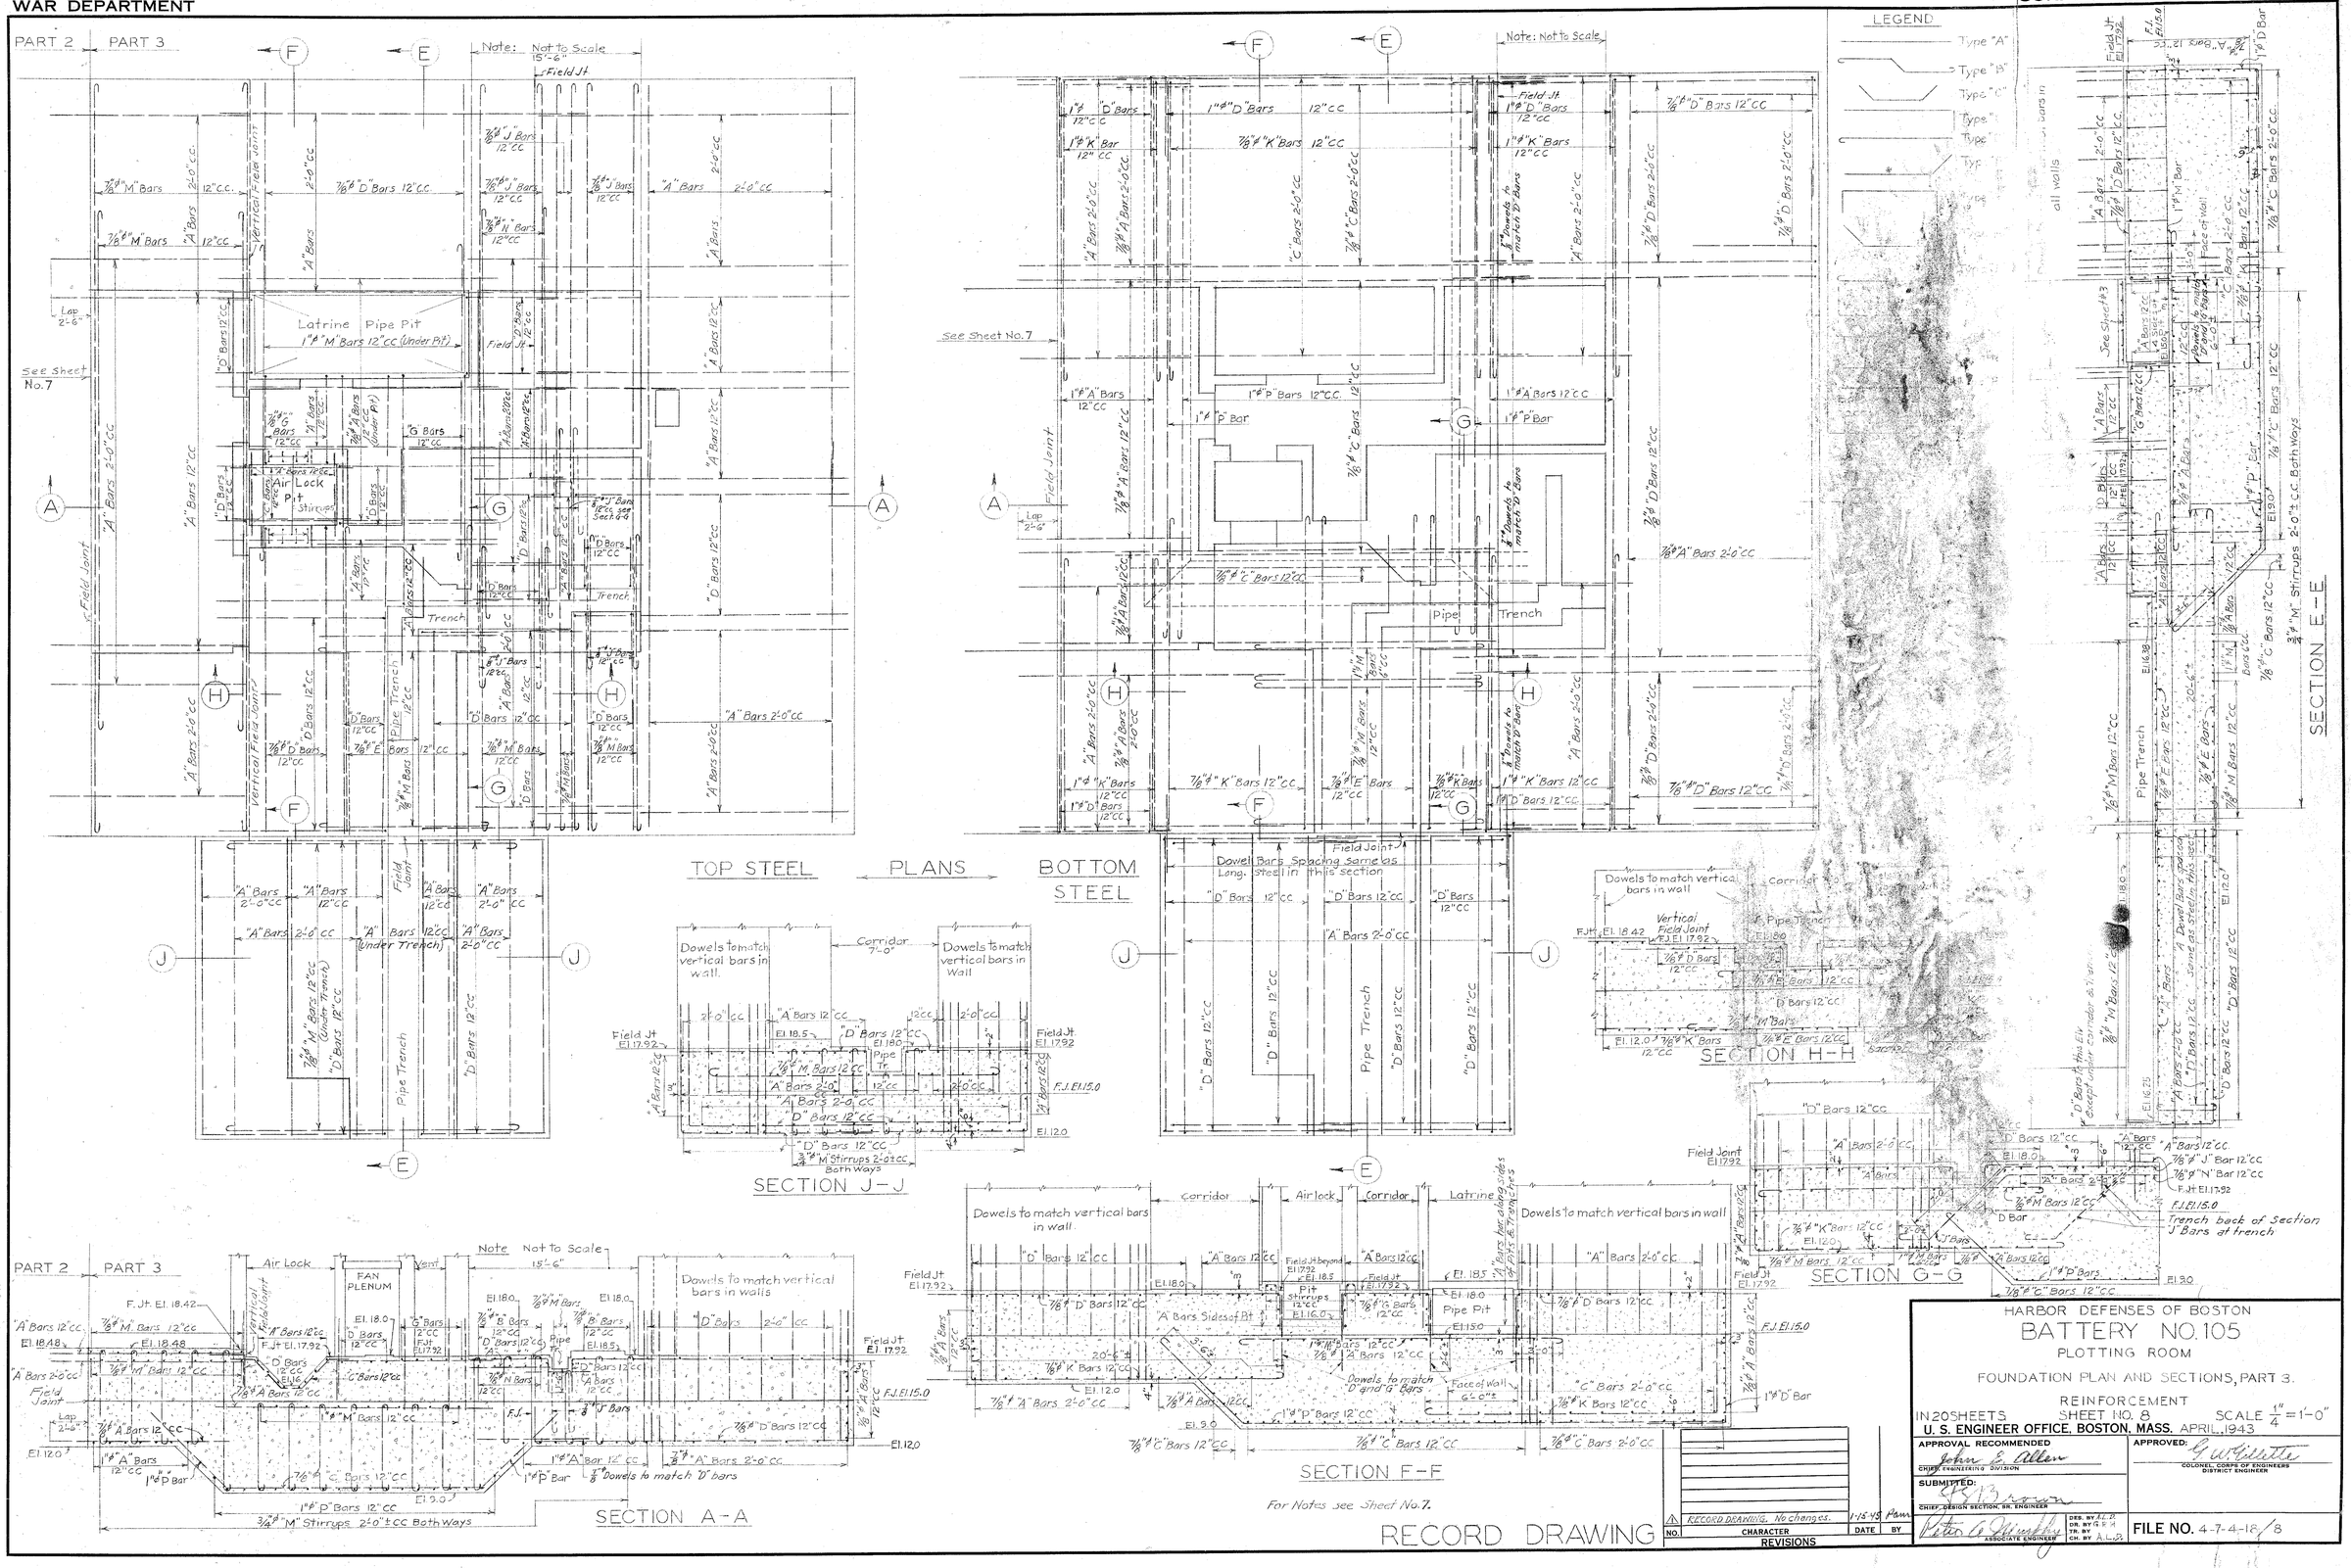

HARBOR DEFENSES OF BOSTON

BATTERY NO. 105

PLOTTING ROOM

FOUNDATION PLAN AND SECTIONS, PART 3.

REINFORCEMENT

IN 20 SHEETS SHEET NO. 8 SCALE $\frac{1}{4}$" = 1'-0"

U. S. ENGINEER OFFICE, BOSTON, MASS. APRIL, 1943

APPROVAL RECOMMENDED: John E. Allen — CHIEF, ENGINEERING DIVISION

APPROVED: G. W. Gillette — COLONEL, CORPS OF ENGINEERS, DISTRICT ENGINEER

SUBMITTED: — CHIEF, DESIGN SECTION, BR. ENGINEER

Peter A. Smith — ASSOCIATE ENGINEER

DES. BY A.L.P. DR. BY G.R.H. TR. BY CH. BY A.L.D.

FILE NO. 4-7-4-18/8

NO.	CHARACTER	DATE	BY
1	RECORD DRAWING. No changes.	1-15-45	Hans

REVISIONS

RECORD DRAWING

