WAR DEPARTMENT

CORPS OF ENGINEERS, U. S. ARMY

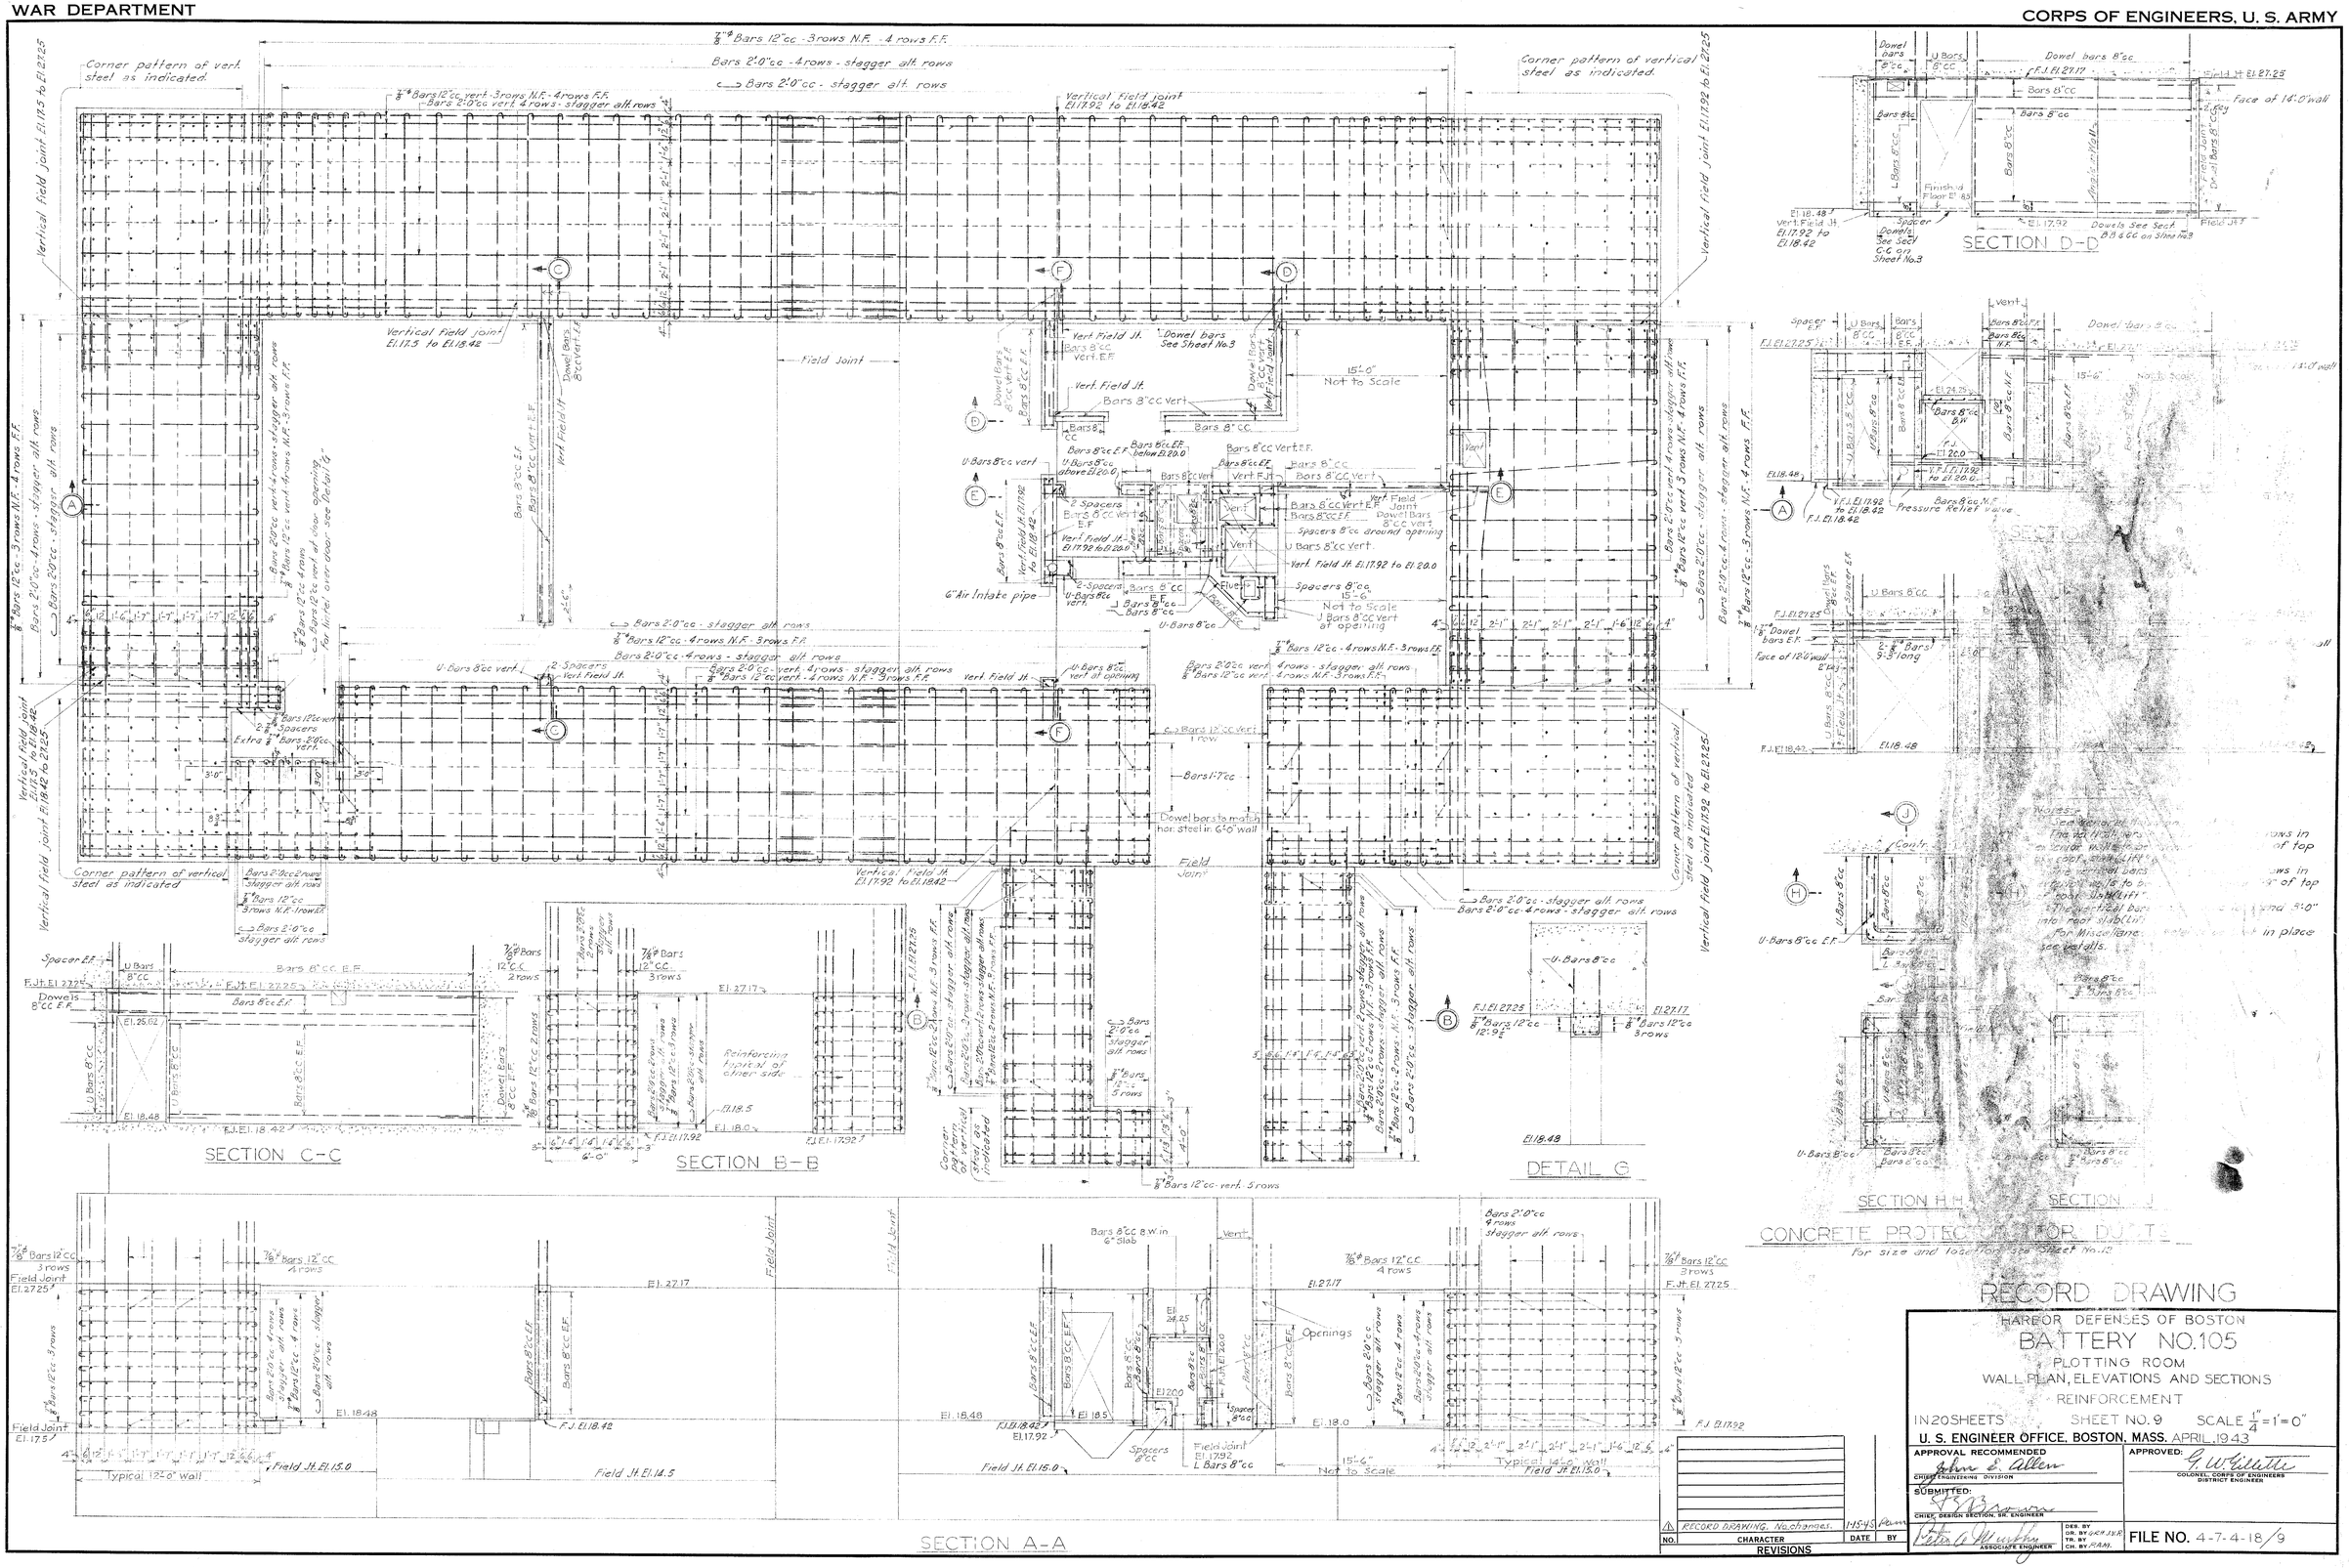

RECORD DRAWING

HARBOR DEFENSES OF BOSTON

BATTERY NO. 105

PLOTTING ROOM

WALL PLAN, ELEVATIONS AND SECTIONS

REINFORCEMENT

IN 20 SHEETS SHEET NO. 9 SCALE $\frac{1}{4}$" = 1'-0"

U. S. ENGINEER OFFICE, BOSTON, MASS. APRIL, 1943

APPROVAL RECOMMENDED: John E. Allen, CHIEF, ENGINEERING DIVISION

APPROVED: G. W. Gillette, COLONEL, CORPS OF ENGINEERS, DISTRICT ENGINEER

SUBMITTED: [signature], CHIEF, DESIGN SECTION, SR. ENGINEER

[signature], ASSOCIATE ENGINEER

DES. BY / DR. BY / TR. BY / CH. BY

FILE NO. 4-7-4-18/9

NO.	CHARACTER	DATE	BY
1	RECORD DRAWING. No changes.	1-15-45	PAM

REVISIONS