WAR DEPARTMENT

CORPS OF ENGINEERS, U. S.

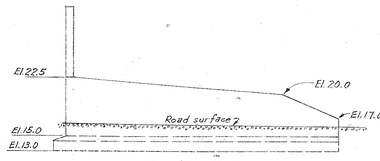

ELEVATION E-E

SCALE: 3/8" = 1'-0"

Note: Reinforcing similar to reinforcing shown in sections C-C & D-D

SECTION F-F

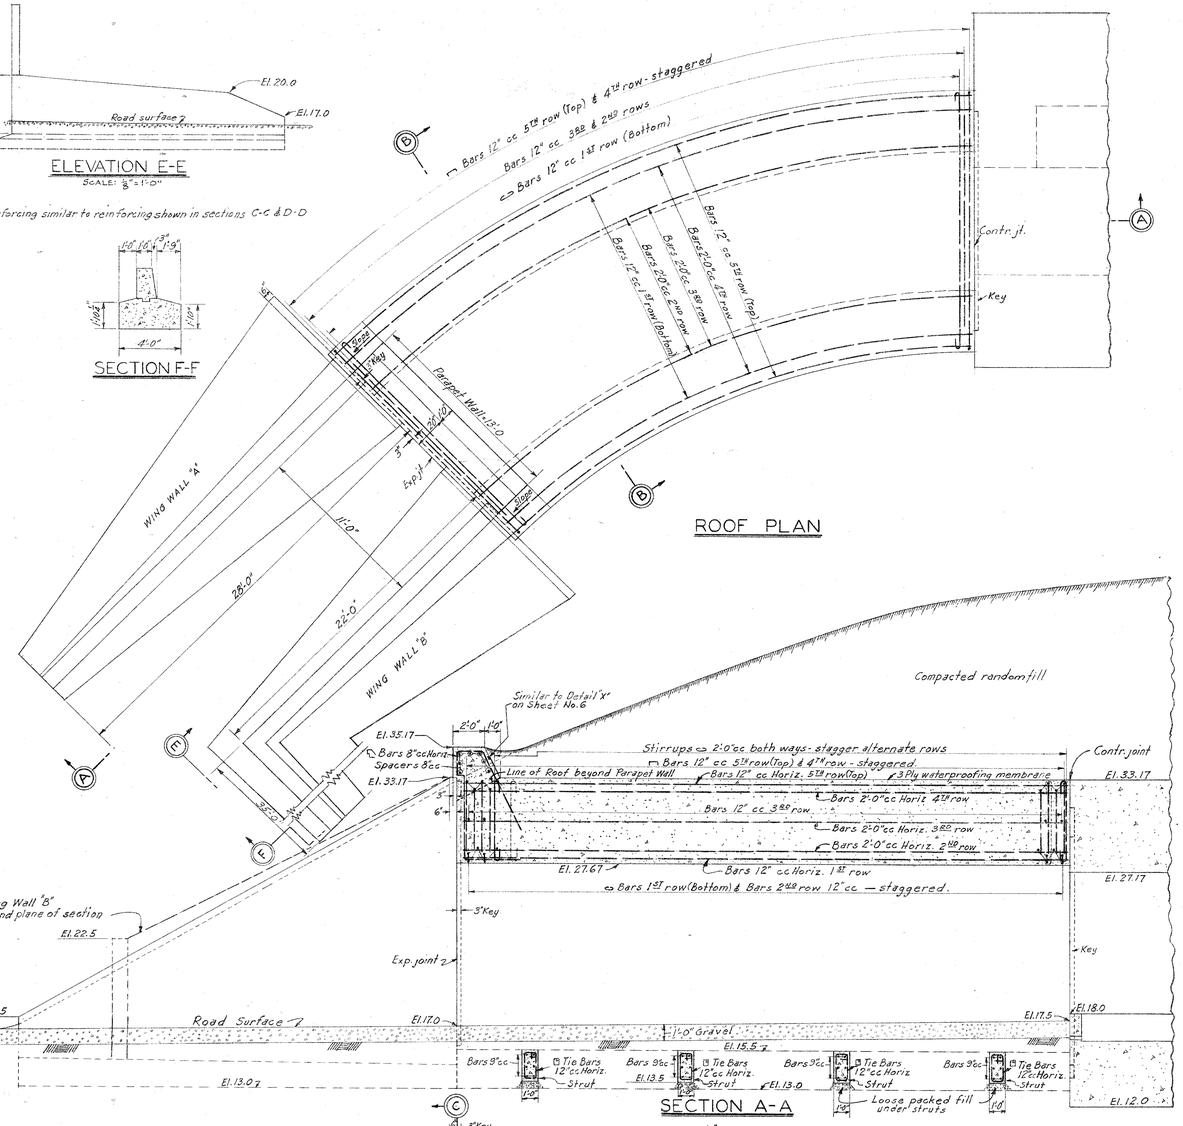

ROOF PLAN

SECTION A-A

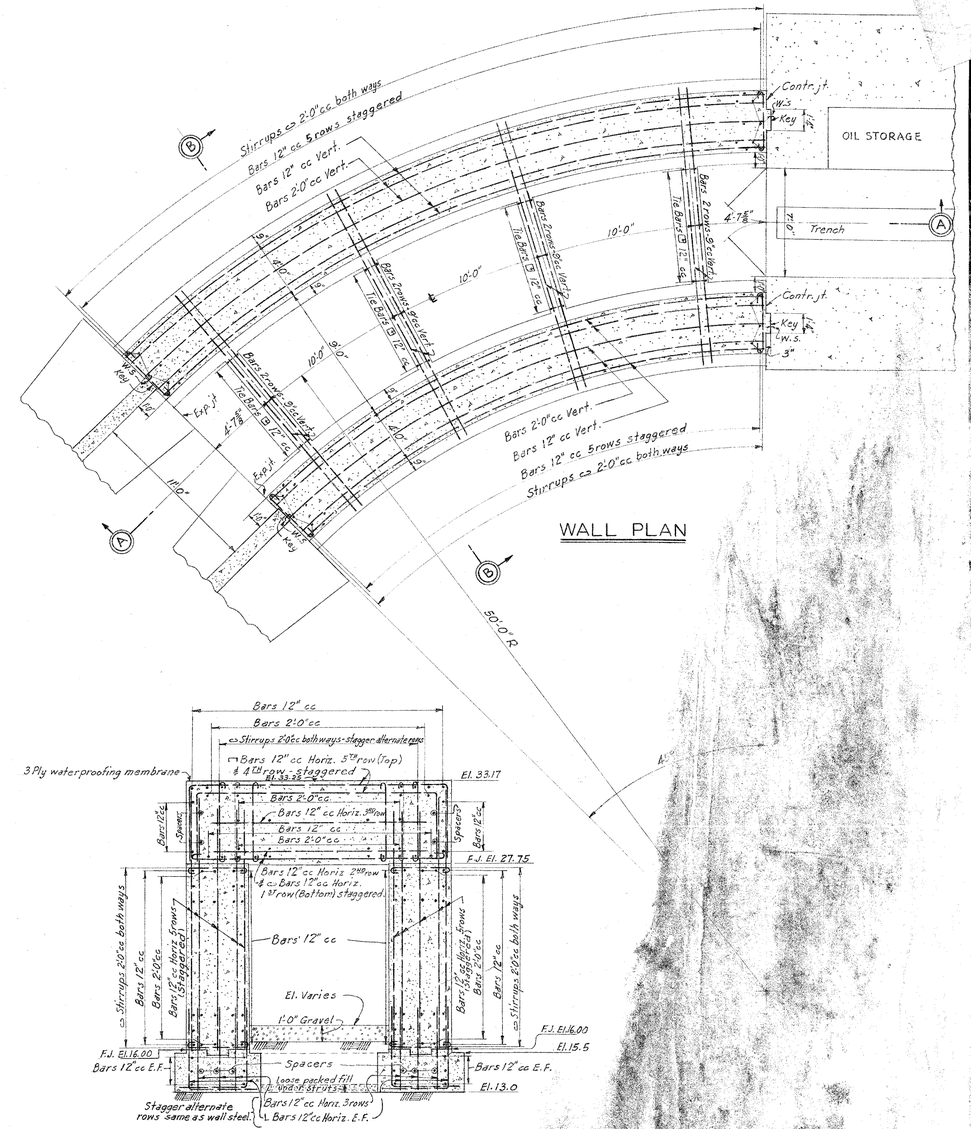

WALL PLAN

SECTION B-B

Note: See Sheet "Wing Wall" No. 5. W.S. Water Stop.

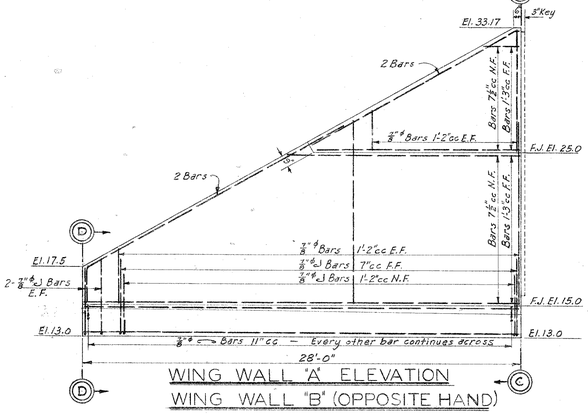

WING WALL "A" ELEVATION

WING WALL "B" (OPPOSITE HAND)

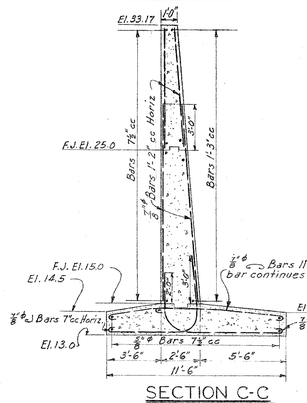

SECTION C-C

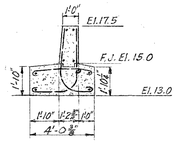

SECTION D-D

DETAIL OF WATERSTOP & CONTRACTION JOINT

SCALE: 1/2" = 1'-0"

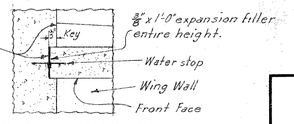

DETAIL OF EXPANSION JOINT

SCALE: 1/2" = 1'-0"

NO.	CHARACTER	DATE	BY
1	Final Field changes made for record drawing	1-15-45	Pam

REVISIONS

RESTRICTED

RECORD DRAWING

HARBOR DEFENSES OF BOSTON

BATTERY NO. 105

PLOTTING ROOM

ENTRANCE STRUCTURE AND WING WALLS

PLAN & SECTIONS - REINFORCEMENT

IN 20 SHEETS — SHEET NO. 9-A — SCALE 1/4" = 1'-0"

U. S. ENGINEER OFFICE, BOSTON, MASS. — APRIL, 1943.

APPROVAL RECOMMENDED: John L. Allen — CHIEF, ENGINEERING DIVISION

APPROVED: G. W. Cullum — COLONEL, CORPS OF ENGINEERS, DISTRICT ENGINEER

SUBMITTED: — CHIEF, DESIGN SECTION, SR. ENGINEER

ASSOCIATE ENGINEER

DES. BY
CK. BY O.E.R.
TR. BY
CK. BY R.J.B.

FILE NO. 4-7-4-18/9-A

