WAR DEPARTMENT

CORPS OF ENGINEERS, U. S. ARMY

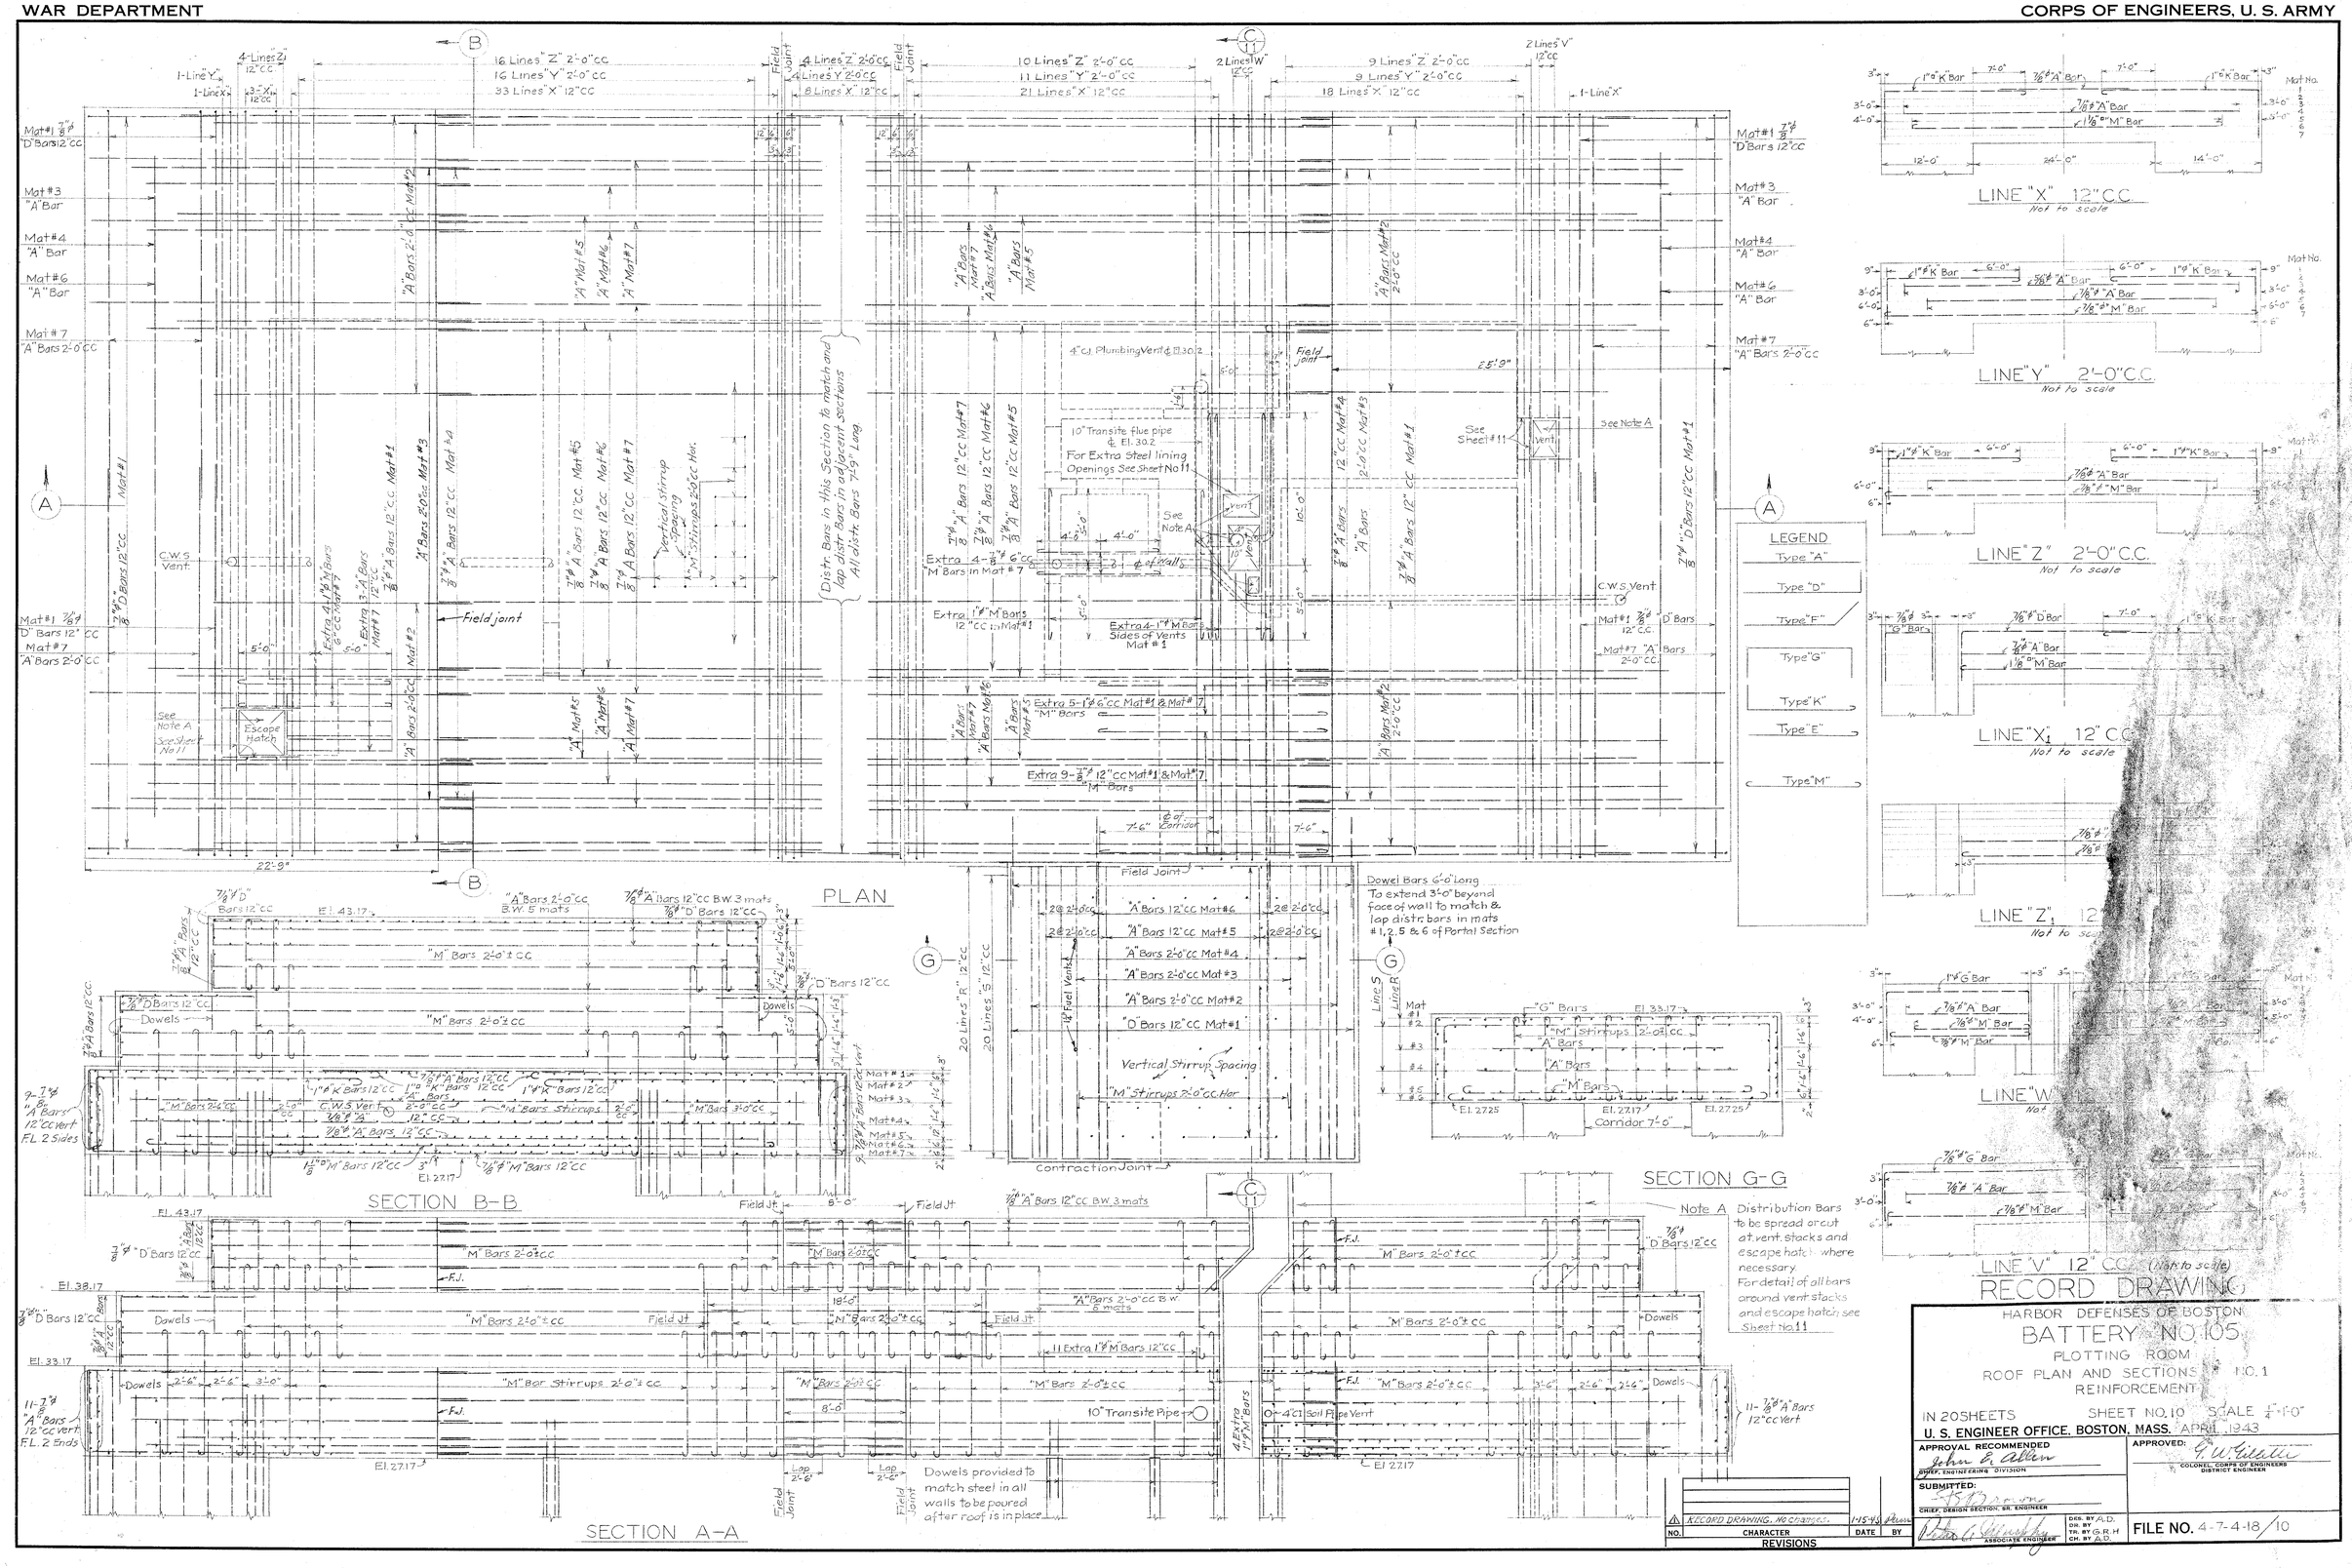

RECORD DRAWING

HARBOR DEFENSES OF BOSTON

BATTERY NO. 105

PLOTTING ROOM

ROOF PLAN AND SECTIONS NO. 1

REINFORCEMENT

IN 20 SHEETS SHEET NO. 10 SCALE 1/4"=1'-0"

U. S. ENGINEER OFFICE, BOSTON, MASS. APRIL 1943

APPROVAL RECOMMENDED: John E. Allen, CHIEF, ENGINEERING DIVISION

SUBMITTED: CHIEF, DESIGN SECTION, SR. ENGINEER

APPROVED: G. W. Gillette, COLONEL, CORPS OF ENGINEERS, DISTRICT ENGINEER

ASSOCIATE ENGINEER

DES. BY A.D. DR. BY TR. BY G.R.H. CH. BY A.D.

FILE NO. 4-7-4-18/10

NO.	CHARACTER	DATE	BY
1	RECORD DRAWING. No changes.	1-15-43	

REVISIONS