WAR DEPARTMENT

CORPS OF ENGINEERS, U. S. ARMY

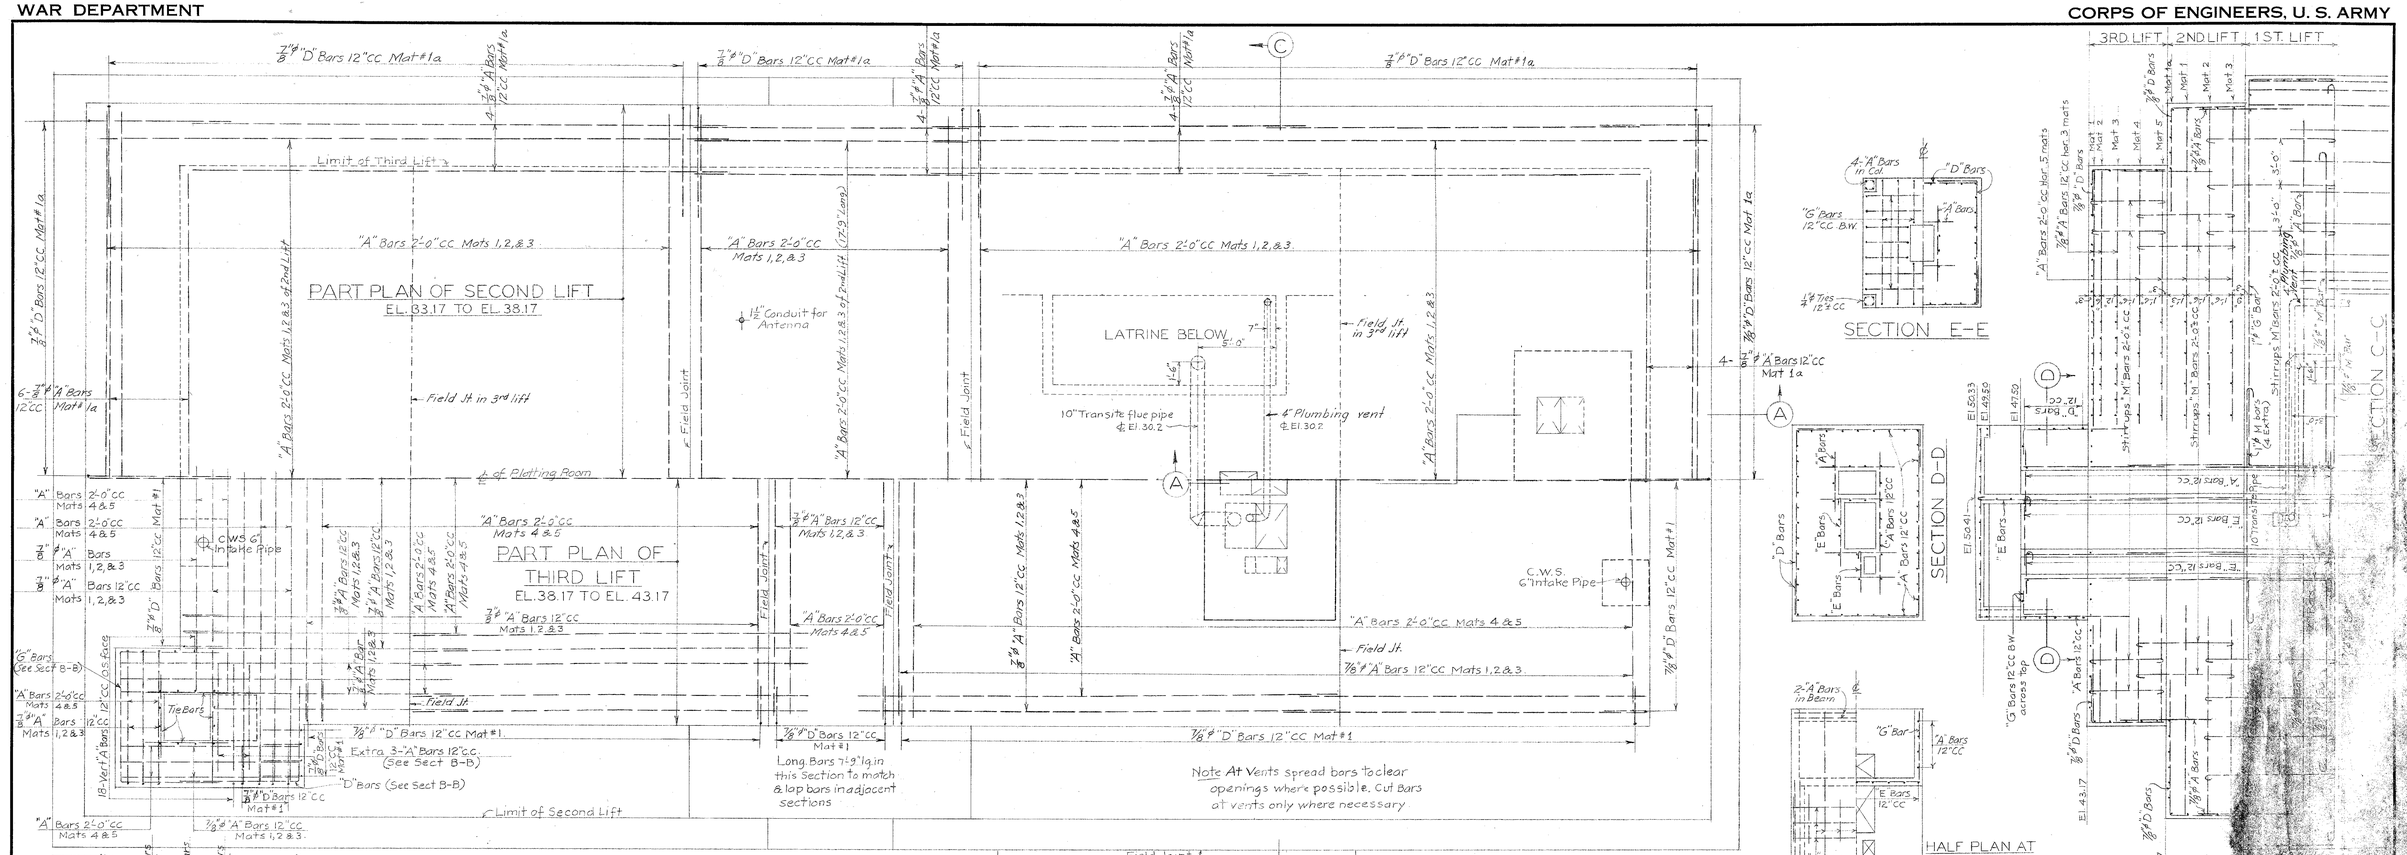

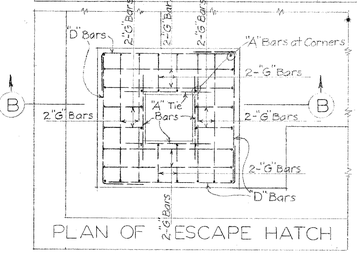

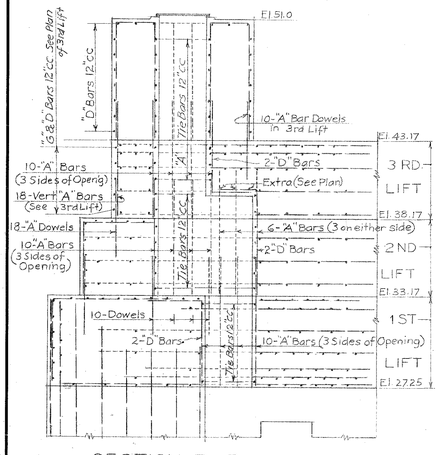

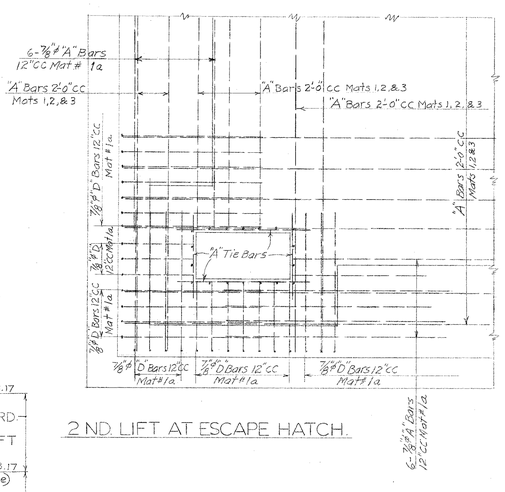

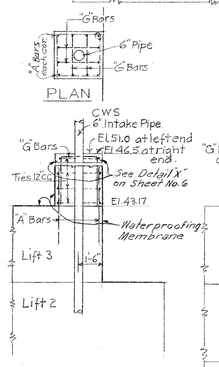

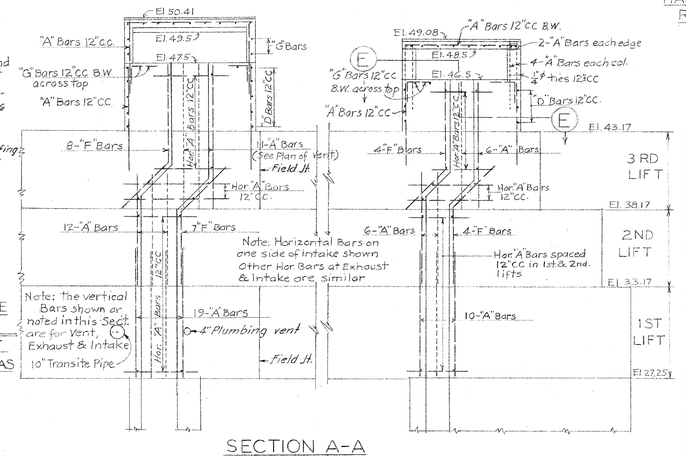

LEGEND

Type "A"

Type "D"

Type "E"

Type "F"

Type "G"

Type "M"

Ties

NOTES

Provide Dowels extending below roof slab to [illegible] walls that are to be poured after roof slab is in [illegible]

Care should be taken in placing pipes to be cast [illegible] that reinforcement will be disturbed as little as [illegible]

Sheet No. 10 should be used in conjunction with [illegible]

Reinforcement at Escape Hatch and Vents shown [illegible]

Provide Dowels as shown to tie the outside bars of [illegible] lifts

Reinforcement in 2nd and 3rd. Lifts symmetrical about center line of Plotting Room except as shown

See Sheet No. 5 for General Notes

RECORD DRAWING

HARBOR DEFENSES OF BOSTON

BATTERY NO. 105

PLOTTING ROOM

ROOF PLAN & SECTIONS NO. 2

REINFORCEMENT

IN 20 SHEETS SHEET NO 11. SCALE $\frac{1}{4}$" = 1'-0"

U. S. ENGINEER OFFICE, BOSTON, MASS. APRIL, 1943

NO.	CHARACTER	DATE	BY
1	RECORD DRAWING. No changes.	1-15-45	Pam

REVISIONS

APPROVAL RECOMMENDED: John E. Allen, CHIEF, ENGINEERING DIVISION

SUBMITTED: C. B. Brainerd, CHIEF, DESIGN SECTION, SR. ENGINEER

Peter A. Murphy, ASSOCIATE ENGINEER

DES. BY A.L.D. DR. BY T.R. BY O.R.H. CH. BY A.L.D.

APPROVED: G. W. Gillette, COLONEL, CORPS OF ENGINEERS, DISTRICT ENGINEER

FILE NO. 4-7-4-18/11

B. L. M., Inc.