WAR DEPARTMENT

CORPS OF ENGINEERS, U. S. ARMY

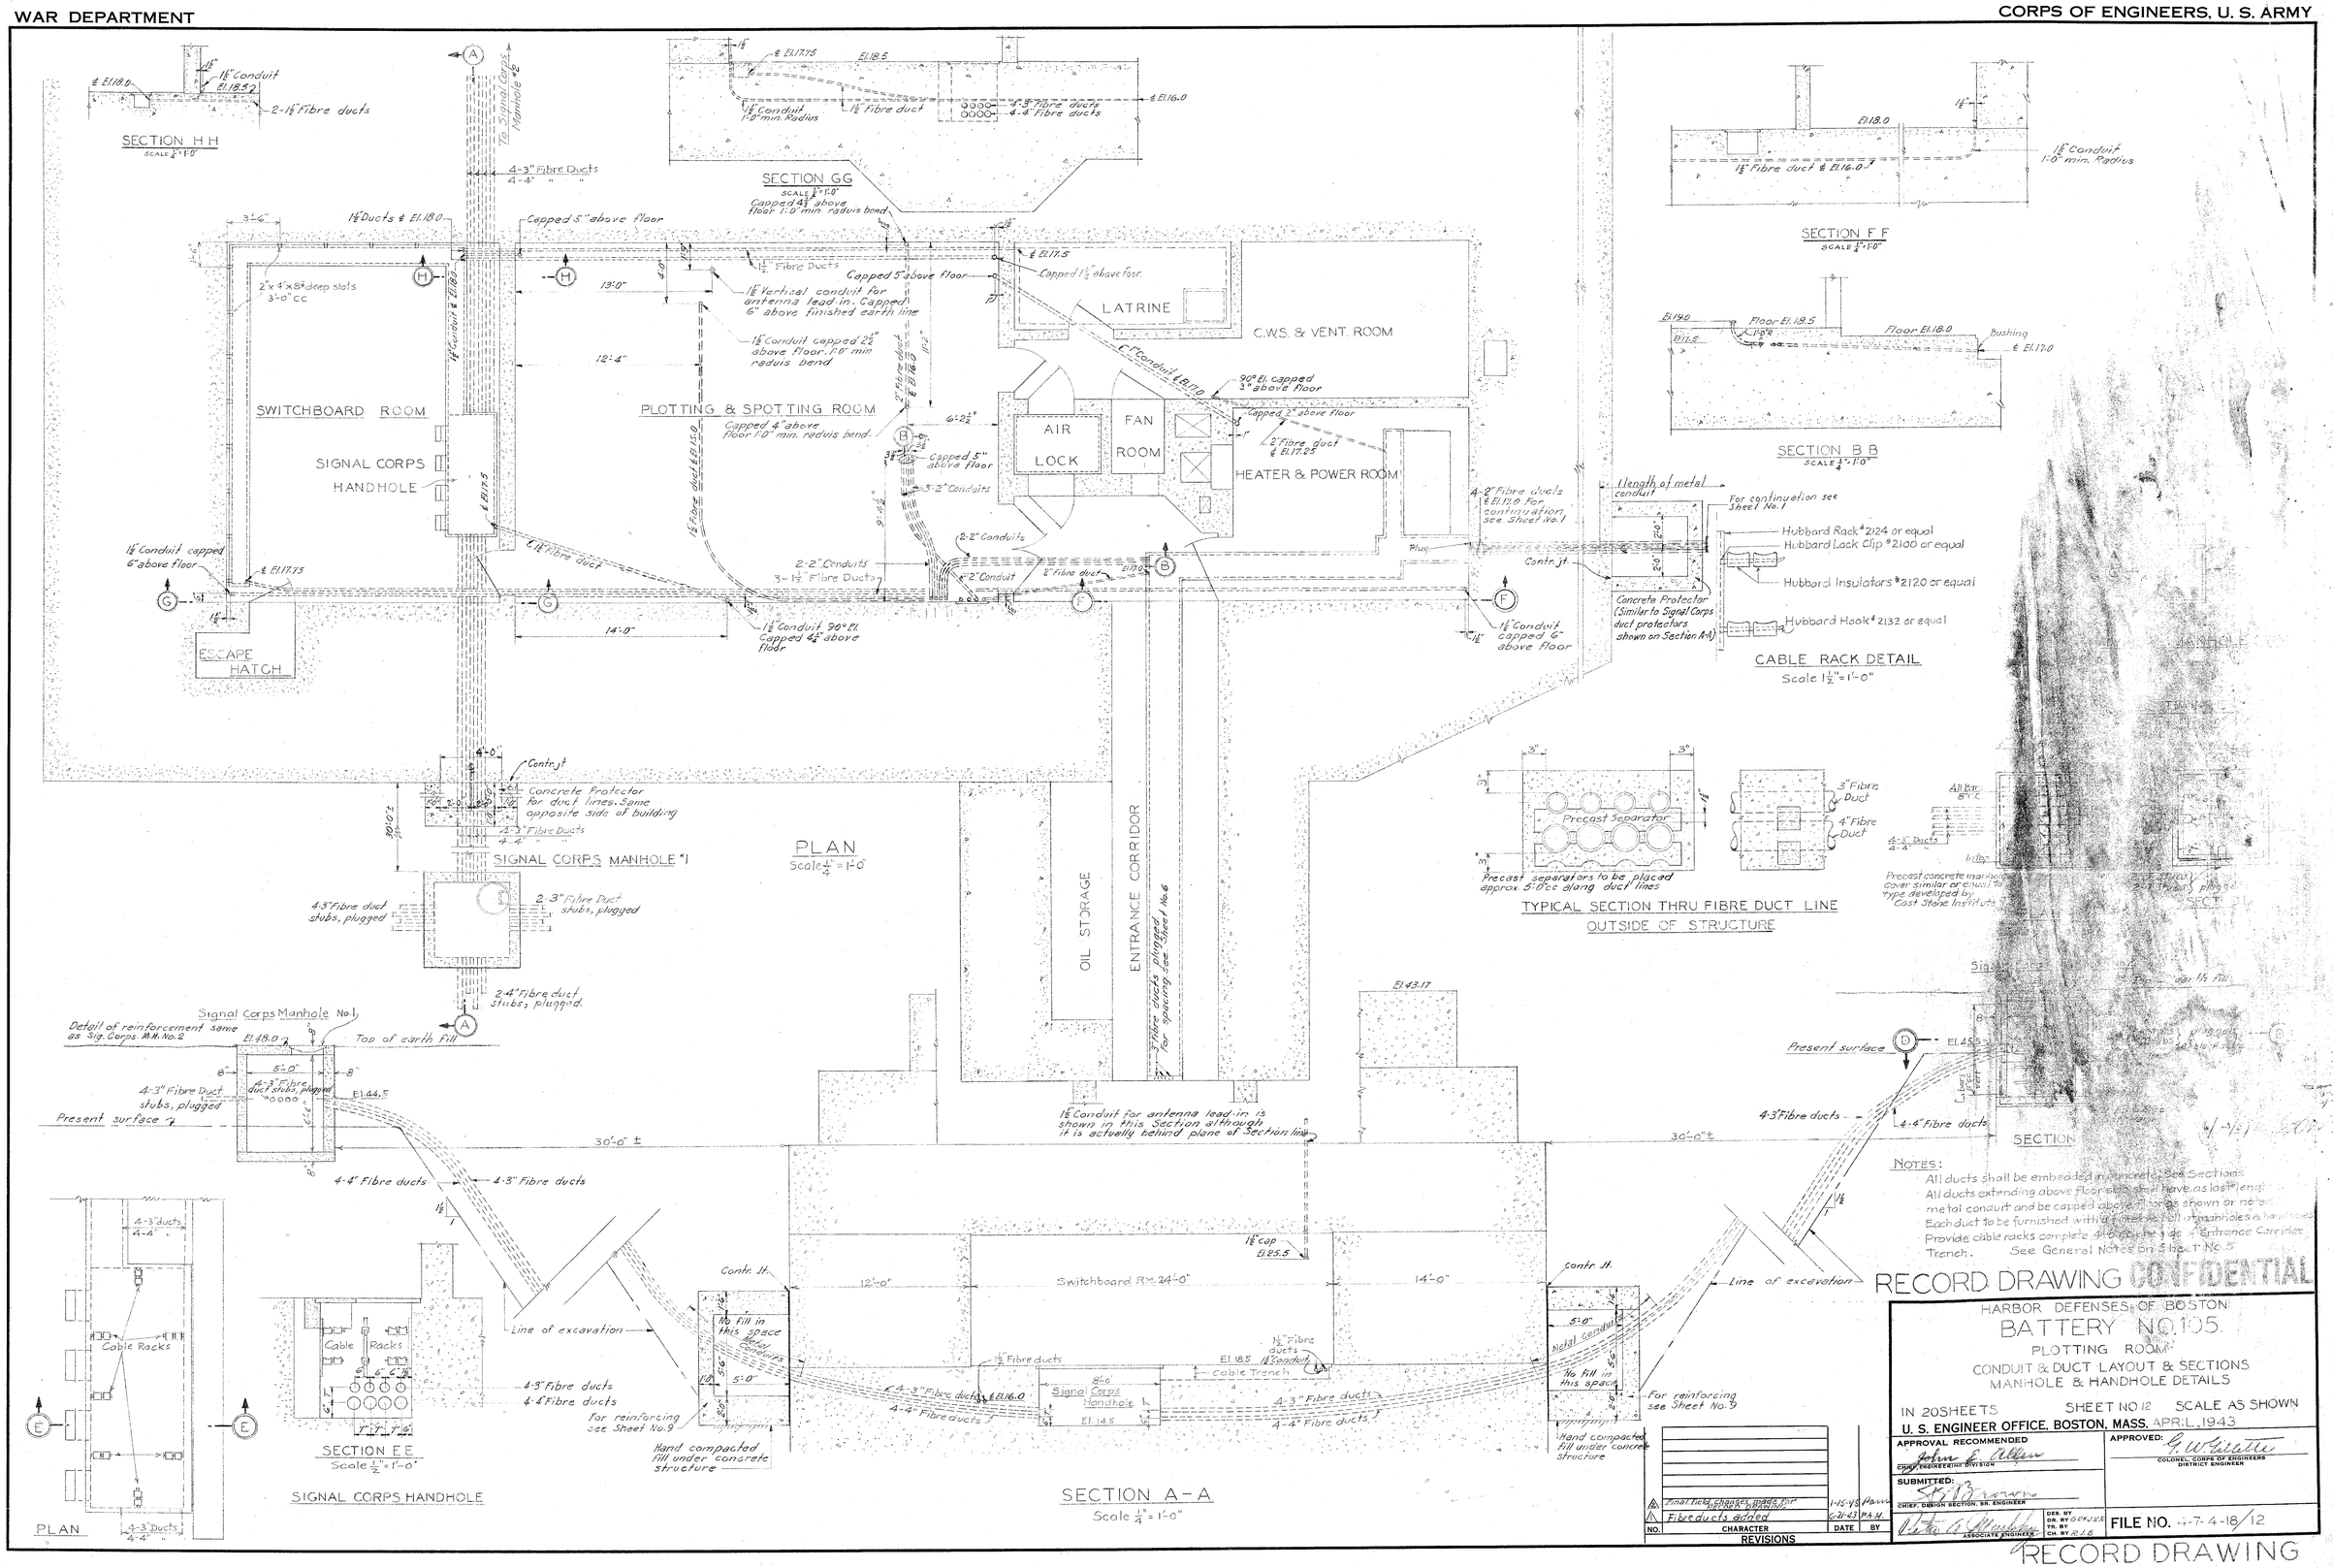

NOTES:
All ducts shall be embedded in concrete. See Sections
All ducts extending above floor slab shall have as last length metal conduit and be capped above floor as shown or noted.
Each duct to be furnished with a fibre or bell at manholes & handholes.
Provide cable racks complete 4'-0" c.c. on side of Entrance Corridor Trench. See General Notes on Sheet No. 5

RECORD DRAWING CONFIDENTIAL

HARBOR DEFENSES OF BOSTON
BATTERY NO. 105
PLOTTING ROOM
CONDUIT & DUCT LAYOUT & SECTIONS
MANHOLE & HANDHOLE DETAILS

IN 20 SHEETS — SHEET NO. 12 — SCALE AS SHOWN

U. S. ENGINEER OFFICE, BOSTON, MASS. APRIL, 1943

APPROVAL RECOMMENDED: John E. Allen, CHIEF, ENGINEERING DIVISION

APPROVED: G. W. Gillette, COLONEL, CORPS OF ENGINEERS, DISTRICT ENGINEER

SUBMITTED: S. B. Brown, CHIEF, DESIGN SECTION, SR. ENGINEER

Peter A. Mueller, ASSOCIATE ENGINEER — DES. BY, DR. BY G.R.M.J.S.R., TR. BY, CH. BY R.J.B.

FILE NO. 4-7-4-18/12

NO.	CHARACTER	DATE	BY
2	Final field changes made for [illegible]	1-15-43	P.A.M.
1	Fibre ducts added	6-21-43	P.A.M.

REVISIONS

RECORD DRAWING