Y-128719

REF.	PART NO.	NAME OF PART	MAT.	MATERIAL SPEC.	PATT. NO.

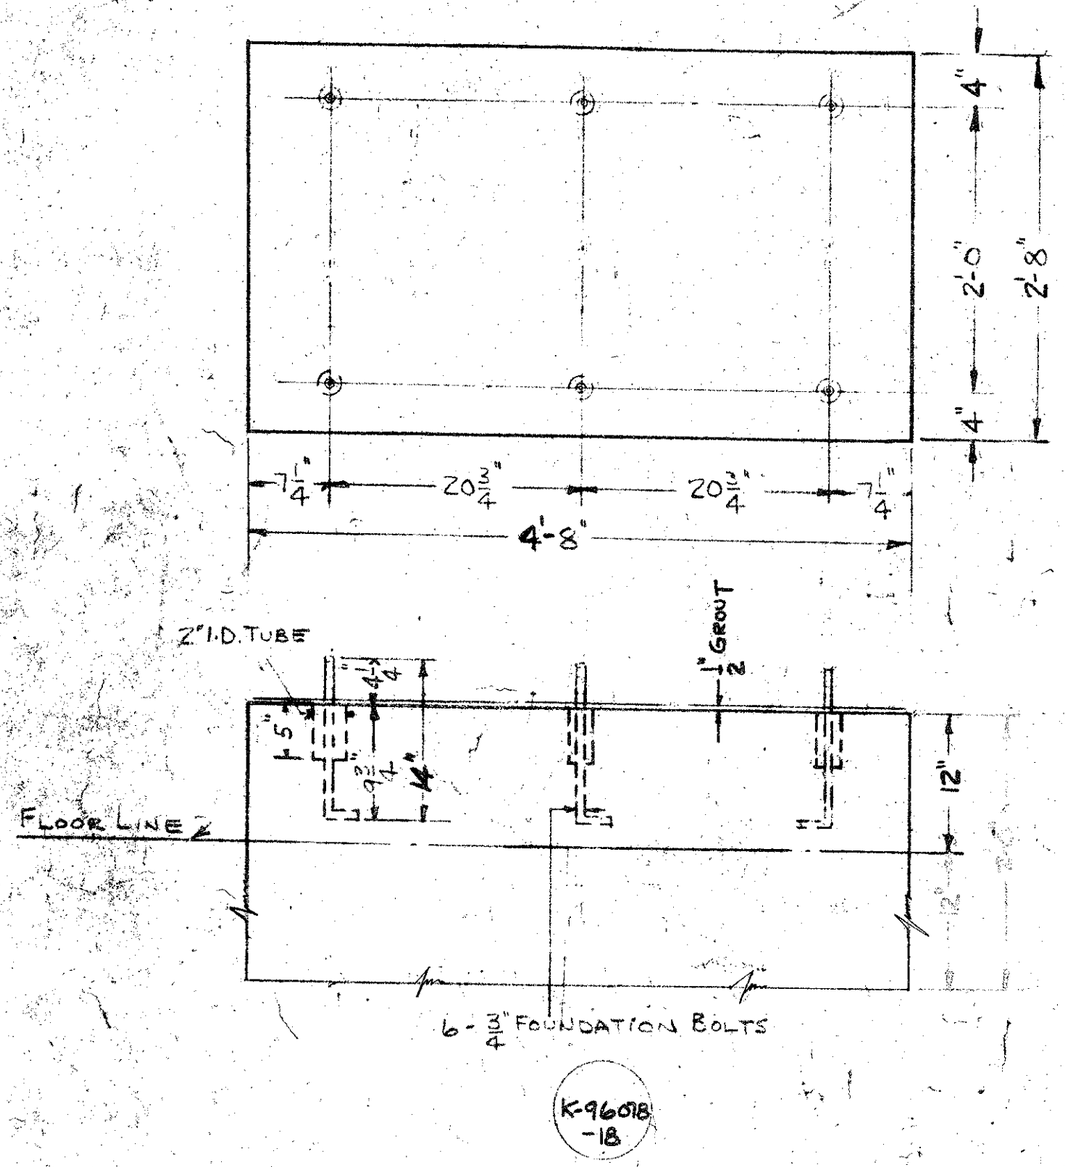

ONE FOUNDATION REQUIRED PER STATION.

For reinforcement see Sheet File No. 4-7-4-11/34.

RECORD DRAWING

APPROVED FOR CHIEF OF ORDNANCE

PRINCIPAL ENGINEER - OFFICE CHIEF OF ORDNANCE

S-6.

K-96018-18

FILE NO. 4-7-4-11/39

FOUNDATION FOR MOTOR DRIVEN AIR COMPRESSOR. (FOR DIESEL ENGINE STARTING).

WORTHINGTON PUMP AND MACHINERY CORPORATION
BUFFALO NEW YORK

ORDER EG-6525 DATE 10-11-42 SCALE 1 INS. - 1 FOOT

DRAWN	CHECKED	APPROVED	
			Y-128719-A

A	2-18-43 ADDED STAMP OF APPROVAL REQ. BY SPEC. DEPT.					

Tolerances For Detail Drawings:
Finished fractional dimensions where no limits given ± 1/64"
" decimal " " " " " ± .005"
Where closer tolerances required limits are specified.
This note does not apply to elevations.