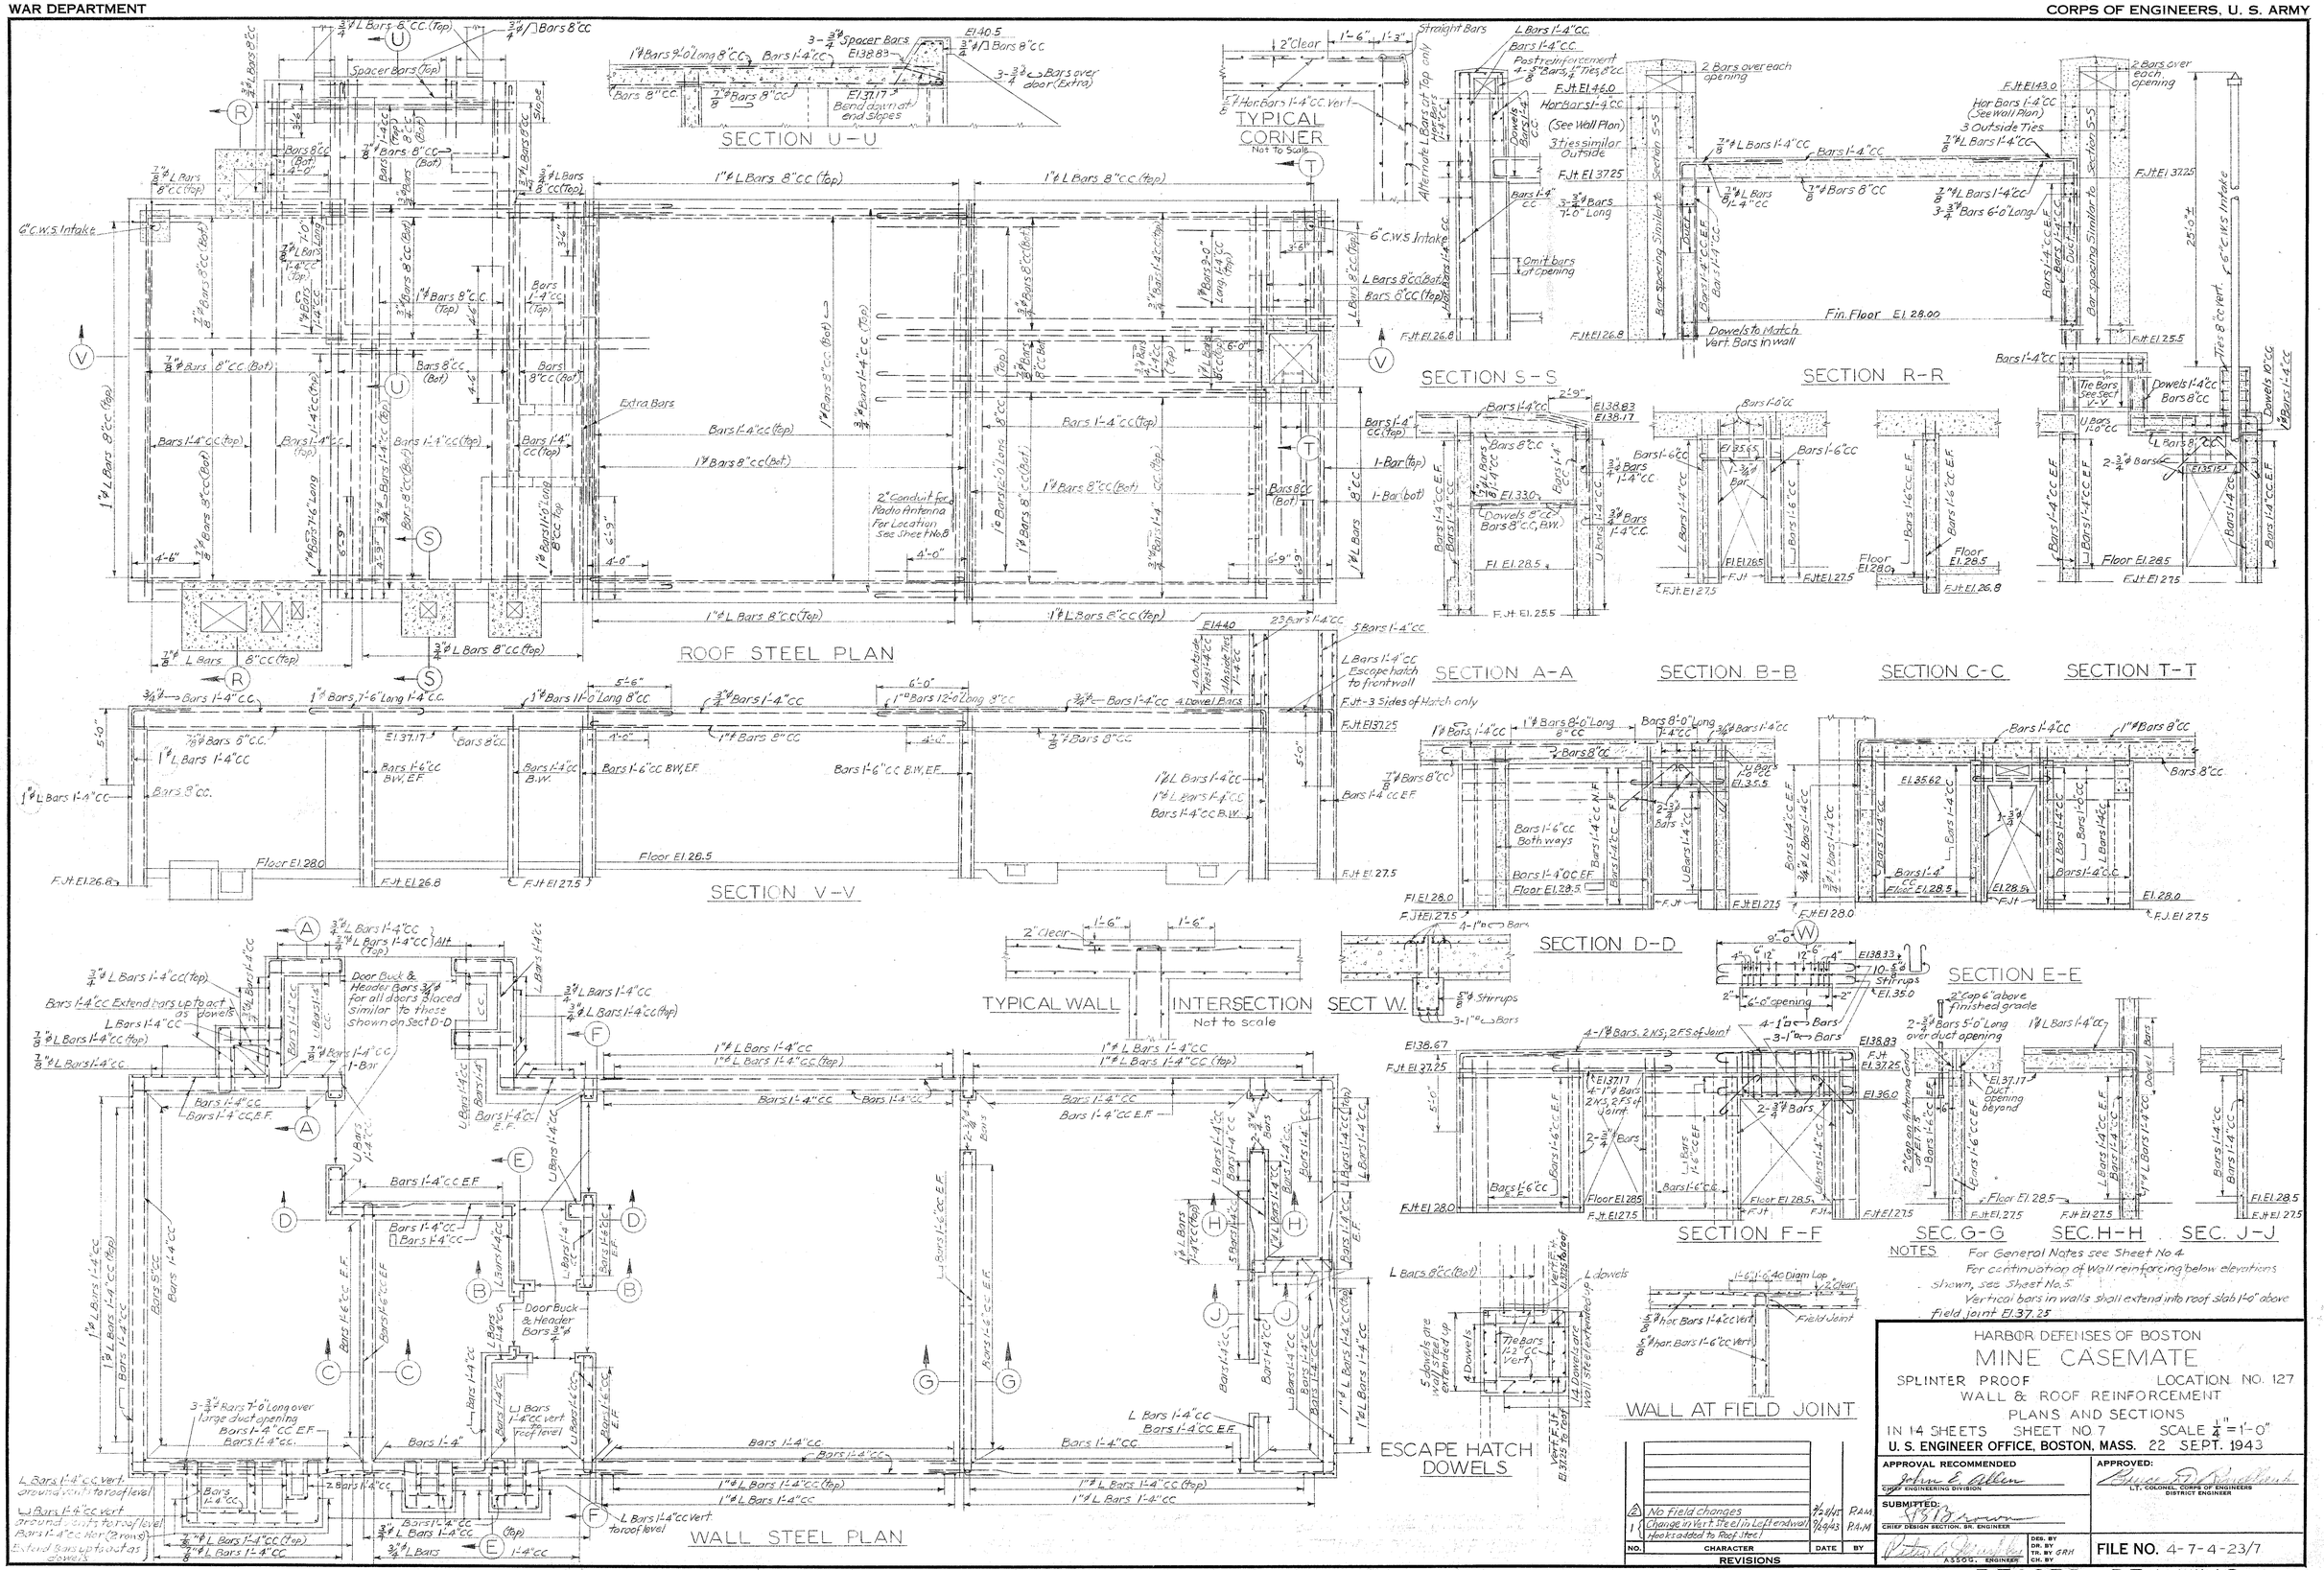

NOTES

For General Notes see Sheet No 4

For continuation of Wall reinforcing below elevations shown, see Sheet No. 5

Vertical bars in walls shall extend into roof slab 1'-0" above field joint El. 37.25

NO.	CHARACTER	DATE	BY
2	No field changes	9/24/45	P.A.M.
1	Change in Vert. Steel in Left end wall Hooks added to Roof Steel	9/29/43	P.A.M.

REVISIONS

HARBOR DEFENSES OF BOSTON

MINE CASEMATE

SPLINTER PROOF — LOCATION NO. 127

WALL & ROOF REINFORCEMENT

PLANS AND SECTIONS

IN 14 SHEETS — SHEET NO. 7 — SCALE 1/4" = 1'-0"

U. S. ENGINEER OFFICE, BOSTON, MASS. 22 SEPT. 1943

APPROVAL RECOMMENDED: John E. Allen, CHIEF ENGINEERING DIVISION

APPROVED: Bruce D. Rawlinson, LT. COLONEL, CORPS OF ENGINEERS, DISTRICT ENGINEER

SUBMITTED: [signature], CHIEF DESIGN SECTION, SR. ENGINEER

[signature], ASSOC. ENGINEER — DES. BY, DR. BY, TR. BY GRH, CH. BY

FILE NO. 4-7-4-23/7

RECORD DRAWING

BOSTON BLUE PRINT NO. 128