WAR DEPARTMENT

CORPS OF ENGINEERS, U. S. ARMY

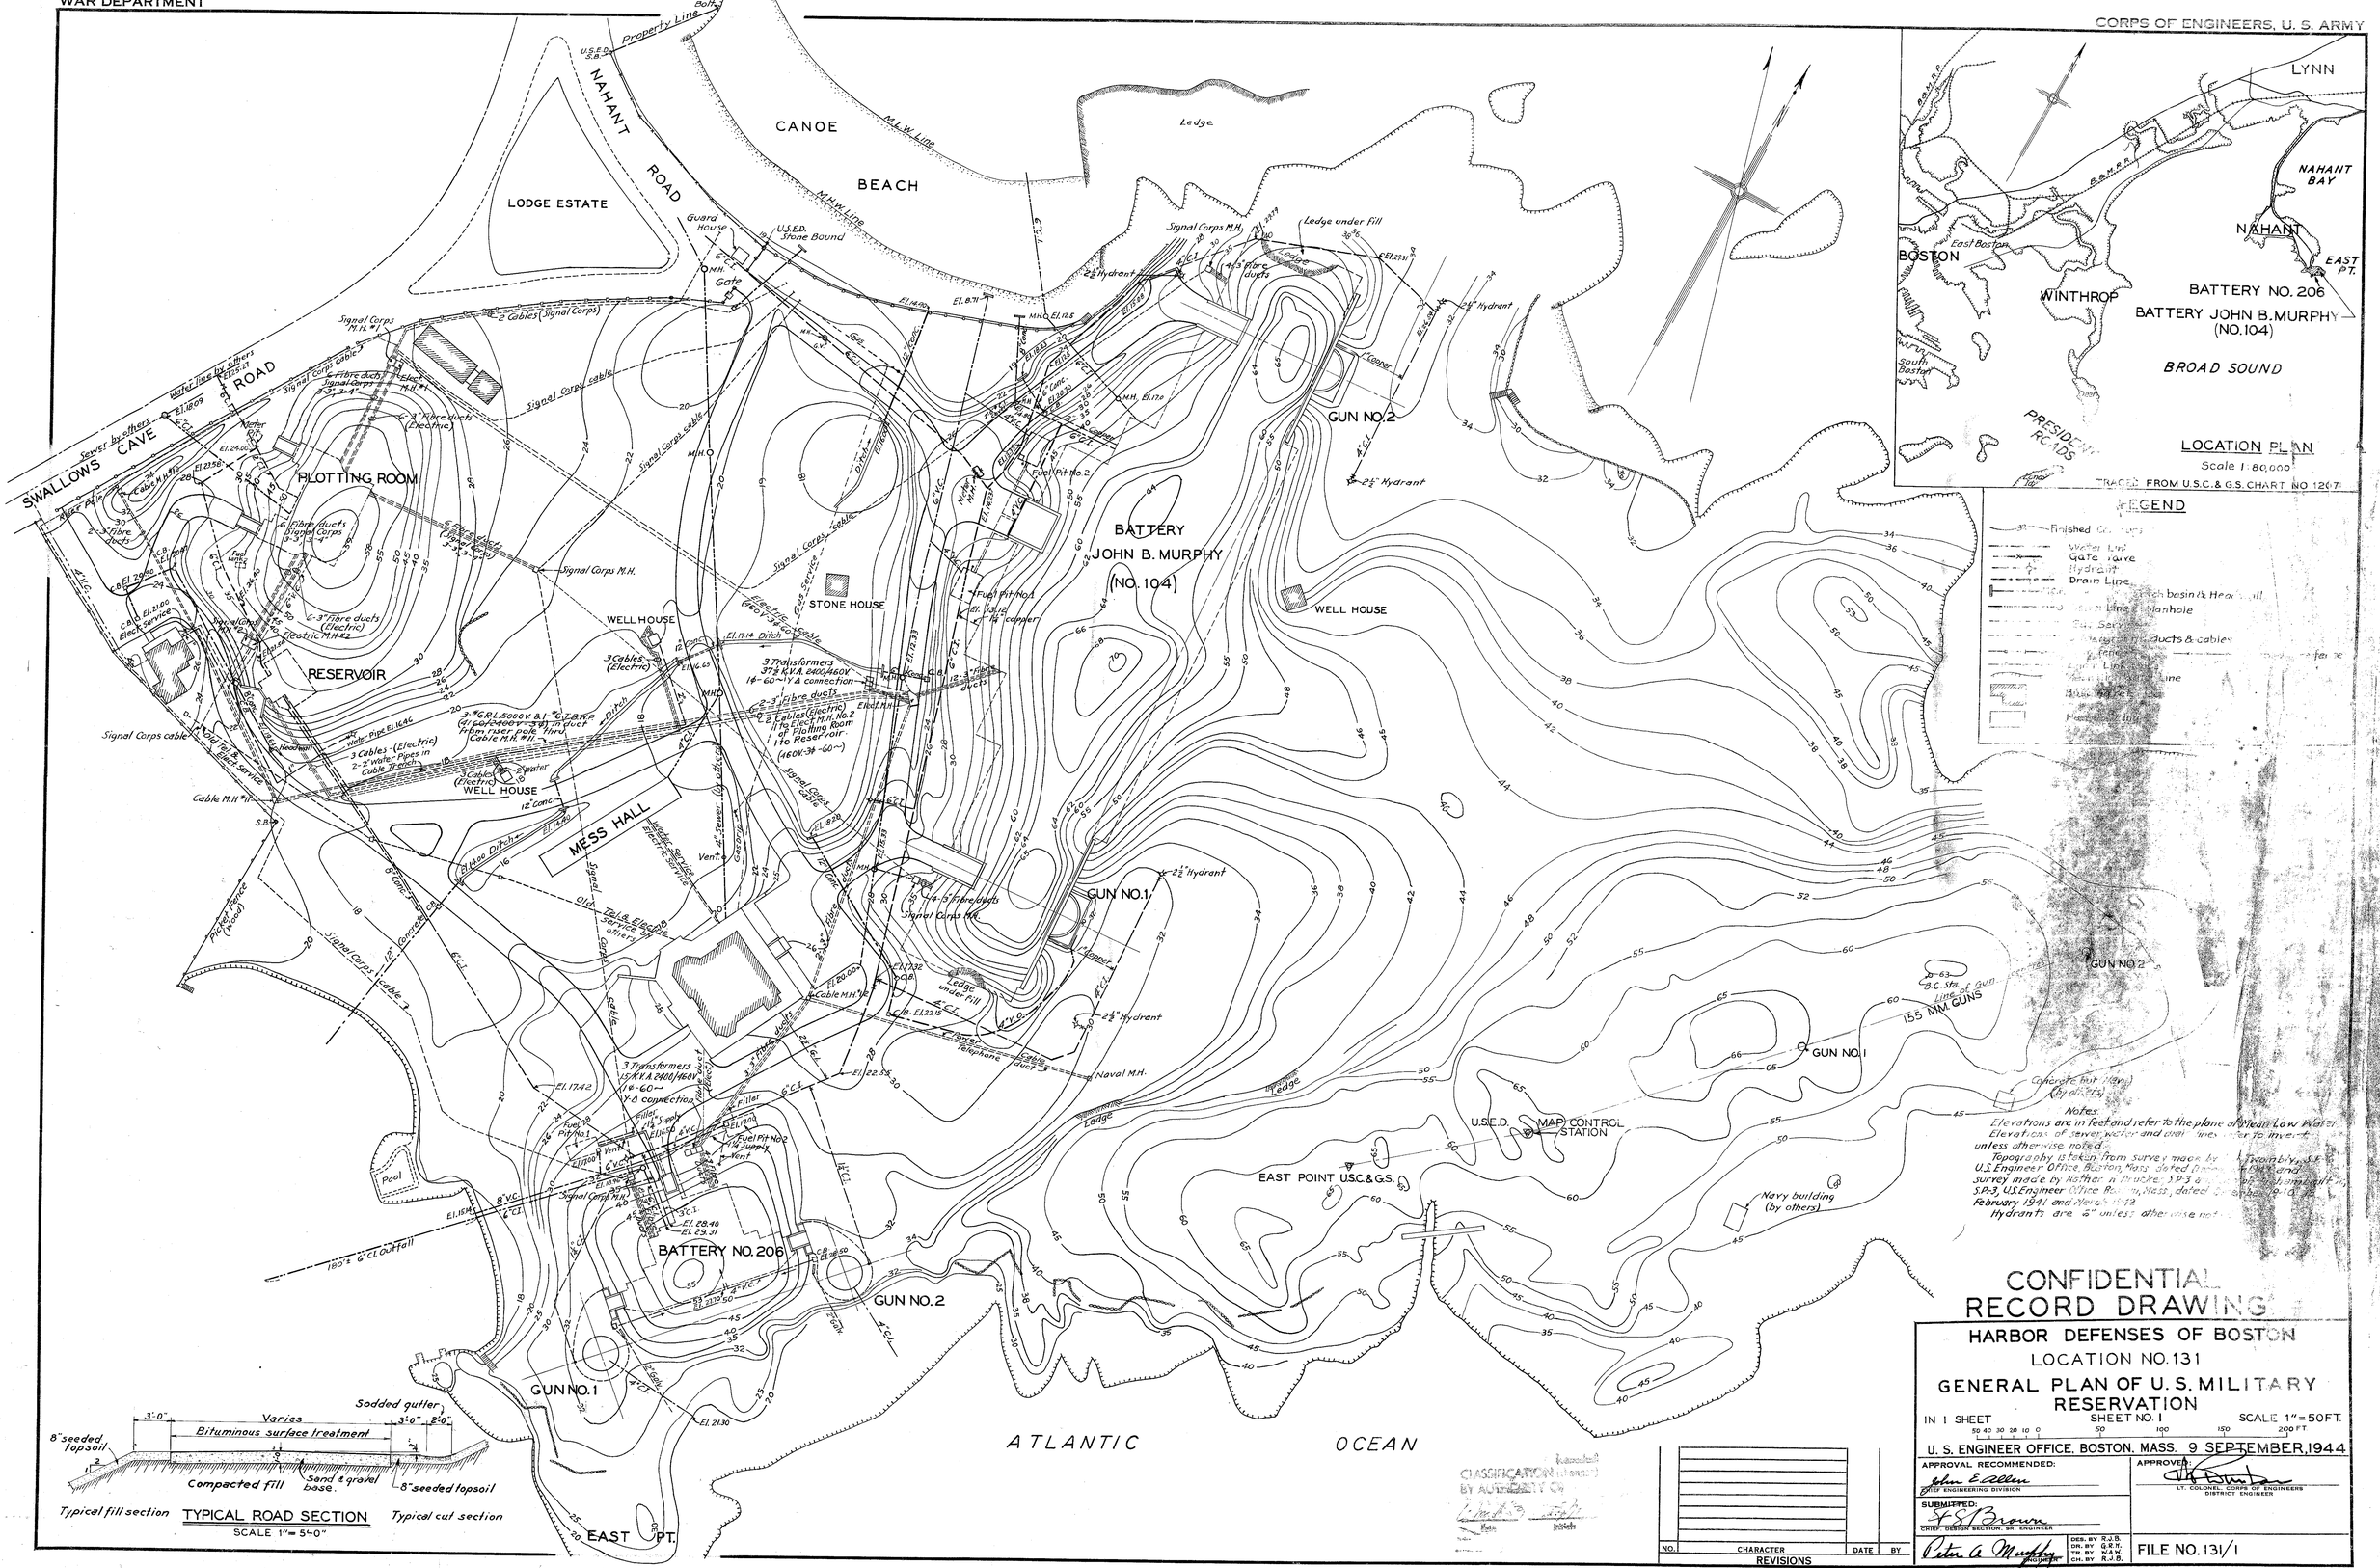

CONFIDENTIAL RECORD DRAWING

HARBOR DEFENSES OF BOSTON

LOCATION NO. 131

GENERAL PLAN OF U. S. MILITARY RESERVATION

IN 1 SHEET — SHEET NO. 1 — SCALE 1" = 50 FT.

U. S. ENGINEER OFFICE, BOSTON, MASS. 9 SEPTEMBER, 1944

APPROVAL RECOMMENDED: John E. Allen, CHIEF ENGINEERING DIVISION

APPROVED: [signature], LT. COLONEL, CORPS OF ENGINEERS, DISTRICT ENGINEER

SUBMITTED: F. S. Brown, CHIEF, DESIGN SECTION, SR. ENGINEER

Peter A. Murphy, ENGINEER

DES. BY R.J.B. DR. BY G.R.H. TR. BY W.A.W. CH. BY R.J.B.

FILE NO. 131/1

NO.	CHARACTER	DATE	BY

REVISIONS

CLASSIFICATION (Revised) BY AUTHORITY OF [signature]

MAKE THIS 1 INCH