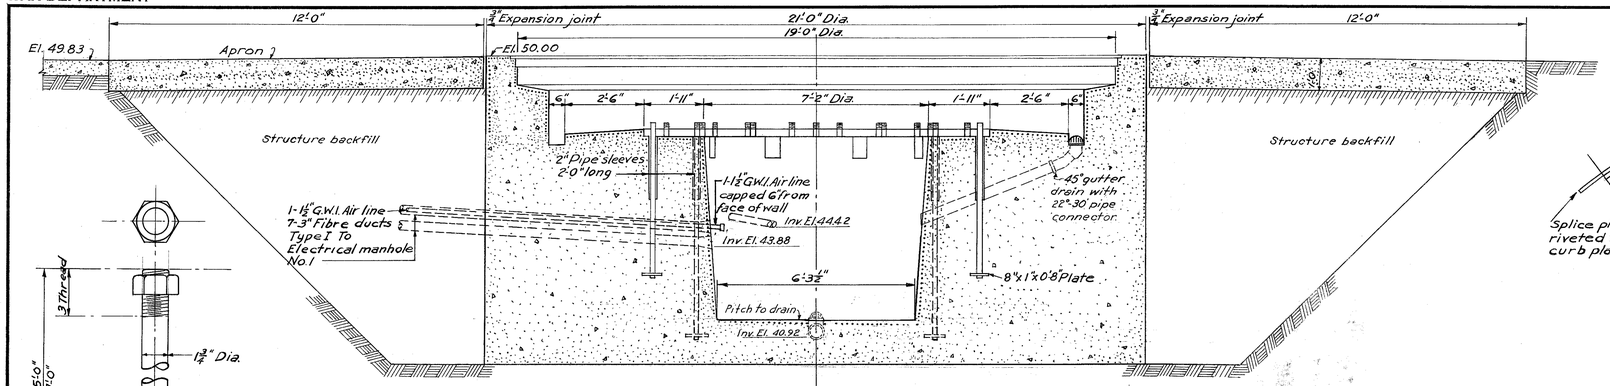

SECTION A-A

SCALE: 1/2" = 1'-0"

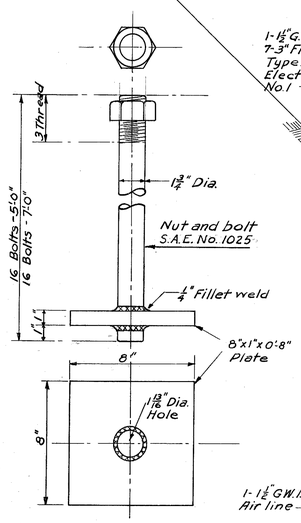

ANCHOR BOLT DETAIL

SCALE 3" = 1'-0"

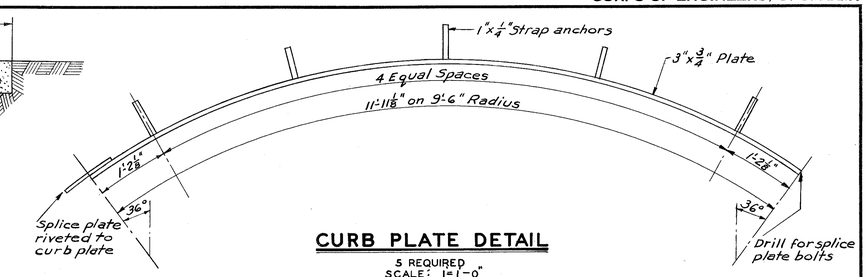

CURB PLATE DETAIL

5 REQUIRED
SCALE: 1" = 1'-0"

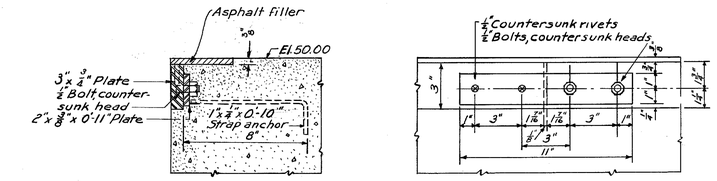

SPLICE PLATE DETAIL

SCALE: 3" = 1'-0"

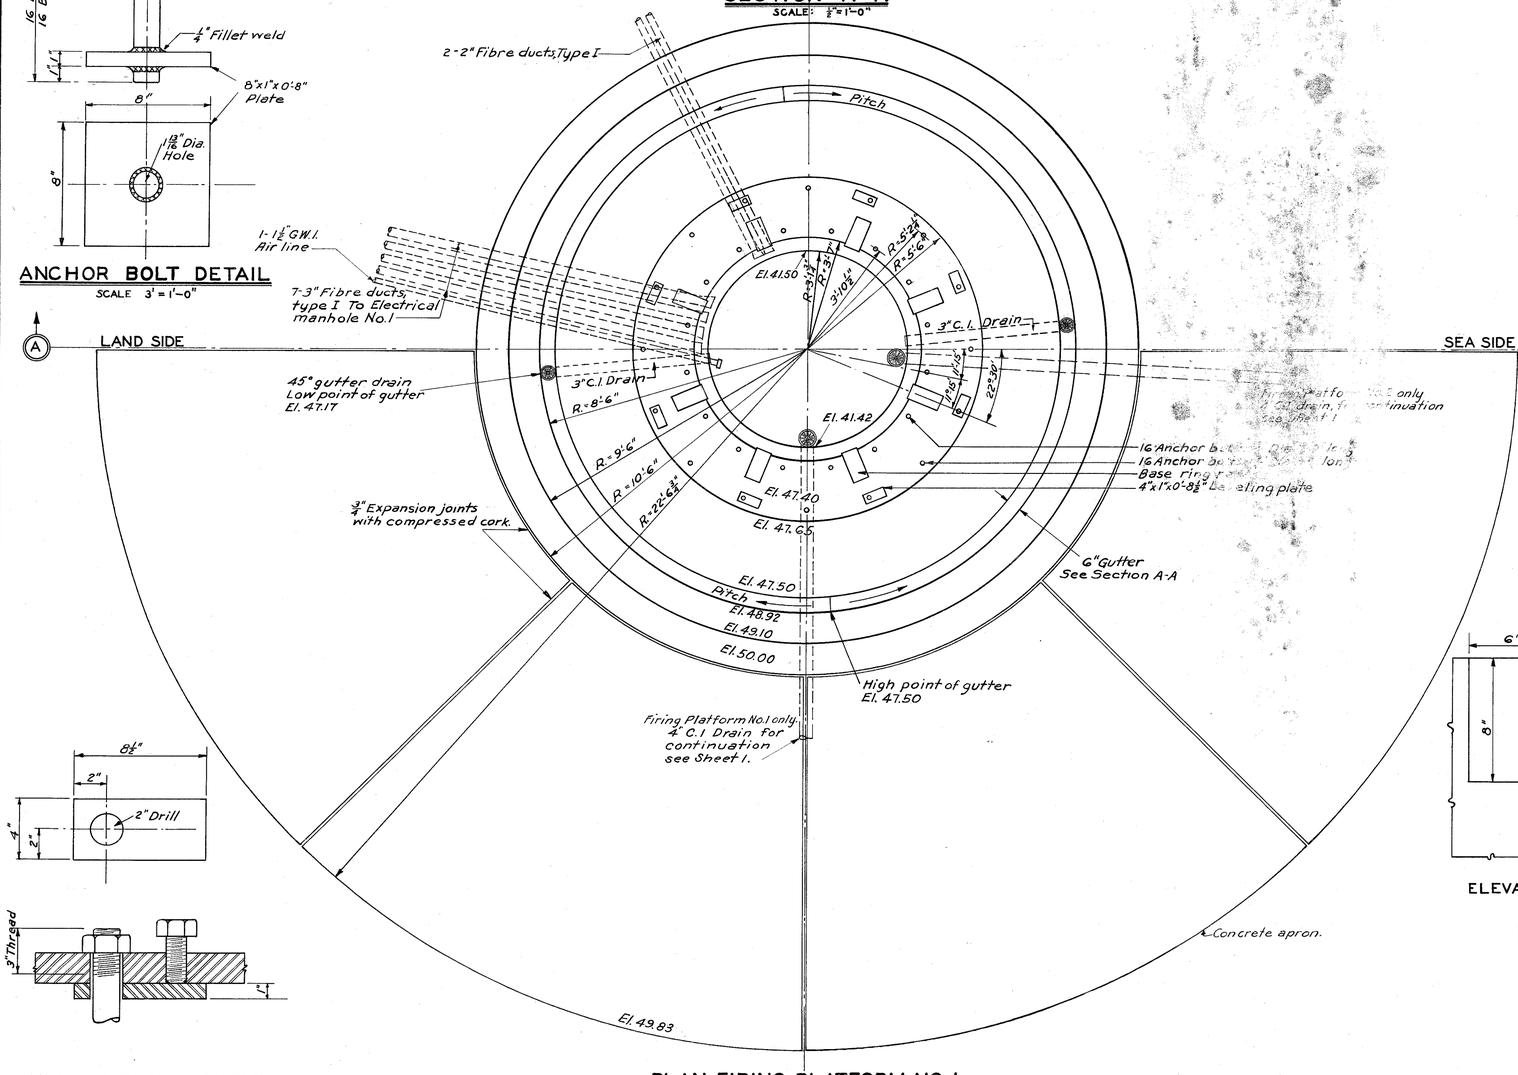

PLAN-FIRING PLATFORM NO. 1

SCALE: 1/2" = 1'-0"

FIRING PLATFORM NO. 2 SIMILAR BUT OPPOSITE HAND

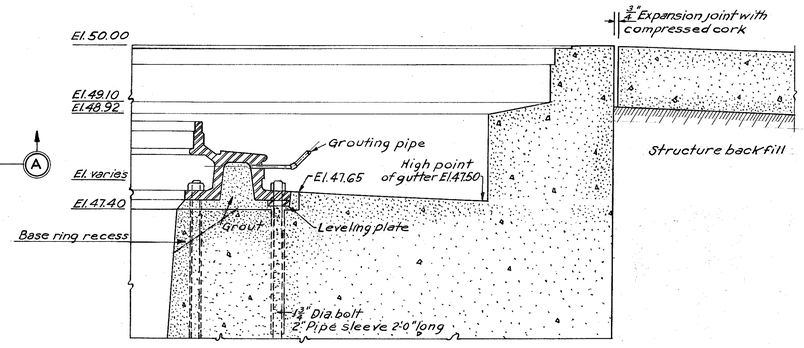

BASE RING DETAIL

SCALE: 1" = 1'-0"

LEVELING PLATE DETAIL

8 REQUIRED
SCALE: 3" = 1'-0"

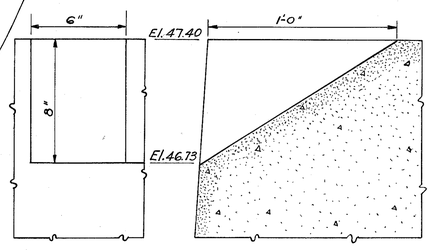

BASE RING RECESS DETAIL

SCALE: 3" = 1'-0"

Notes:
For General Notes see Sheet 2
For continuation of fibre ducts and air line see Sheet 5

RESTRICTED
RECORD DRAWING

HARBOR DEFENSES OF BOSTON
BATTERY NO. 207

FIRING PLATFORM-MASONRY

IN 6 SHEETS | SHEET NO. 6 | SCALE AS SHOWN

U. S. ENGINEER OFFICE, BOSTON, MASS. 22 JULY 1944

APPROVAL RECOMMENDED: John E. Allen, CHIEF ENGINEERING DIVISION

APPROVED: H. L. Rumsey, LT. COLONEL, CORPS OF ENGINEERS, DISTRICT ENGINEER

SUBMITTED: J. B. Brown, CHIEF DESIGN SECTION, SR. ENGINEER

Peter A. Murphy, DRAFTSMAN

DES. BY O.C.E. | DR. BY L.H.M. | TR. BY W.A.W. | CH. BY L.H.M.

FILE NO. 207/6

NO.	CHARACTER	DATE	BY

REVISIONS

BOSTON BLUE PRINT CO.